

Pike  
 C 207  
 11-23-76

MISSISSIPPI  
 BOARD OF WATER COMMISSIONERS  
 416 North State Street  
 Jackson, Mississippi 39201

WATER WELL DRILLERS LOG

11-23 1976 *Felgerald Well Service* *Pike*  
 date well completed firm name county well located

LANDOWNER:  
*Clyde Price*  
*R.R. Gress, Mrs.*  
 (mailing address)

description of formations encountered	from	to
<i>Red clay</i>	<i>0</i>	<i>20</i>
<i>Red sand</i>	<i>20</i>	<i>50</i>
<i>Coarse sand &amp; gravel</i>	<i>50</i>	<i>170</i>

WELL LOCATION:  
 sec. *28* T. *4* N. R. *9* E  
*14* miles *0* of *Prichard*  
 (distance) (direction) (nearest town)

WELL PURPOSE: *Home*  
 (home, irrigation, municipal, industrial)

- WELL COMPLETION DATA:
- (1) diameter (inches) *4*
  - (2) total depth (feet) *70*
  - (3) static water level (feet) *22* below above top of ground.
  - (4) casing *PVC* *62*  
 (material) (depth)  
*4* if telescope see back.  
 (size)
  - (5) screen *8* *62*  
 (length) (depth to top)  
*4* *PVC*  
 (size) (material)
  - (6) pump *1/2* *10*  
 (HP) (yield gpm)  
*elec*  
 (type power)
  - (7) electric log *no*  
 (yes of no)  
 (organization running log)
  - (8) how well bottom plugged *Sand block*


DRILLERS REMARKS:

RECEIVED  
 DEC 23 1976

MISS. OF WATER COMMISSIONERS

If well telescopes please sketch and show depths.

GROUND LEVEL

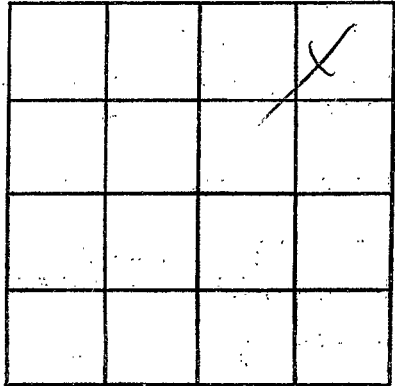

SECTION 28

Please indicate well location X.

ADDITIONAL INFORMATION

If more than one screen,  
show locations of each on sketch.