

Pike
 C-2018
 1-21-77

MISSISSIPPI
 BOARD OF WATER COMMISSIONERS
 416 North State Street
 Jackson, Mississippi 39201

WATER WELL DRILLERS LOG


21 Jan 1977 H. Carnahan & Son PIKE
 date well completed firm name county well located

LANDOWNER:	description of formations encountered	from	to
Pope Catholic Church Prichard, Miss. (mailing address)			
WELL LOCATION: sec 26 T 4 N R 9 E 1 miles E of Prichard (distance) (direction) (nearest town)			
WELL PURPOSE: (home, irrigation, municipal, industrial)			
WELL COMPLETION DATA:			
(1) diameter (inches) 4			
(2) total depth (feet) 94			
(3) static water level (feet) 75 below top of ground.			
(4) casing (material) PL (depth) 38			
(size) If telescope see back.			
(5) screen (length) 6 (depth to top) 38			
(size) 4 (material) PL			
(6) pump 1/2 (HP) 8 (yield gpm)			
(type power) gas			
(7) electric log (yes or no)			
(organization running log)			
(8) how well bottom plugged good			
DRILLERS REMARKS:			

RECEIVED
 FEB 24 1977
 MISS. Bd. OF WATER COMMISSIONERS

If well telescopes please sketch and show depths.

GROUND LEVEL

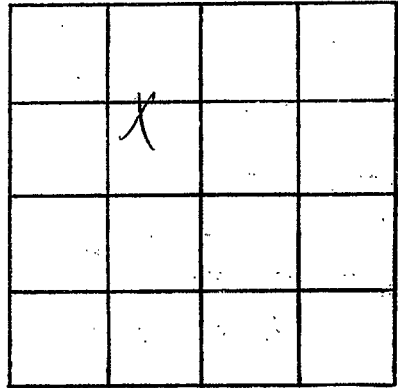

SECTION 26

Please indicate well location X.

ADDITIONAL INFORMATION

If more than one screen, show locations of each on sketch.