

Pike  
C 209  
3/22/77

MISSISSIPPI  
 BOARD OF WATER COMMISSIONERS  
 416 North State Street  
 134 Jackson, Mississippi 39201

WATER WELL DRILLERS LOG

3-22 1977 Fitzgerald Well Service Pike  
 date well completed firm name county well located


LANDOWNER:	description of formations encountered	from	to
<u>Leonard Kabelein</u>			
<u>R.R. Summit, Miss.</u> (mailing address)	<u>Red clay</u>	<u>17</u>	<u>20</u>
	<u>Red sand &amp; gravel</u>	<u>20</u>	<u>135</u>
	<u>Coarse sand &amp; gravel</u>	<u>135</u>	<u>155</u>
WELL LOCATION:			
sec. <u>30</u> T <u>4</u> N R <u>9</u> E S W			
<u>10</u> miles <u>E</u> of <u>Memph</u> (distance) (direction) (nearest town)			
WELL PURPOSE:			
<u>Home</u> (home, irrigation, municipal, industrial)			
WELL COMPLETION DATA:			
(1) diameter (inches) <u>4</u>			
(2) total depth (feet) <u>155</u>			
(3) static water level (feet) <u>110</u> below above top of ground.			
(4) casing <u>PVC</u> , <u>147</u> , (material) (depth)			
<u>4</u> If telescope see back. (size)			
(5) screen <u>8</u> , <u>147</u> (length) (depth to top)			
<u>4</u> , <u>PVC</u> (size) (material)			
(6) pump <u>1/2</u> , <u>10</u> (HP) (yield gpm)			
<u>elec</u> (type power)			
(7) electric log <u>No</u> (yes or no)			
(organization running log)			
(8) how well bottom plugged <u>sealed</u>			
DRILLERS REMARKS:			

RECEIVED  
 MAR 20 1977

MISS. BD. OF WATER COMMISSIONERS

If well telescopes please sketch and show depths.

GROUND LEVEL

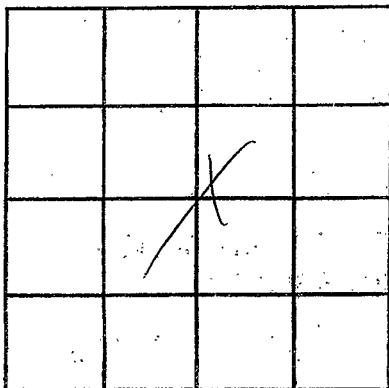

SECTION

30

Please indicate well location X.

ADDITIONAL INFORMATION

If more than one screen, show locations of each on sketch.