

Pike
C 2020
3-23-77

MISSISSIPPI
 BOARD OF WATER COMMISSIONERS
 416 North State Street
 Jackson, Mississippi 39201

WATER WELL DRILLERS LOG

3-23 1977 Fitzgualdell Sewer Pike
 date well completed firm name county well located

LANDOWNER: Doyle Price
P.O. Tylertown Miss.
 (mailing address)

| description of formations encountered | from | to |
|---------------------------------------|-----------------|-----------|
| | <u>Red clay</u> | <u>0</u> |
| <u>Red sand</u> | <u>20</u> | <u>80</u> |
| <u>Coarse sand & gravel</u> | <u>80</u> | <u>75</u> |

WELL LOCATION:
20 sec. 26 T. 4 N. R. 9 E. W.
12 miles E of McComb
 (distance) (direction) (nearest town)

WELL PURPOSE: Home
 (home, irrigation, municipal, industrial)

- WELL COMPLETION DATA:
- (1) diameter (inches) 4
 - (2) total depth (feet) 95
 - (3) static water level (feet) 17 below above top of ground.
 - (4) casing PVC 87
 (material) (depth)
4 If telescope see back.
 (size)
 - (5) screen 8 87
 (length) (depth to top)
4 PVC
 (size) (material)
 - (6) pump 1/2 10
 (HP) (yield gpm)
Electric
 (type power)
 - (7) electric log No
 (yes or no)
 (organization running log)
 - (8) how well bottom plugged Level short


DRILLERS REMARKS:

RECEIVED
 MAR 30 1977

MISS. BD. OF WATER COMMISSIONERS

If well telescopes please sketch and show depths.

GROUND LEVEL

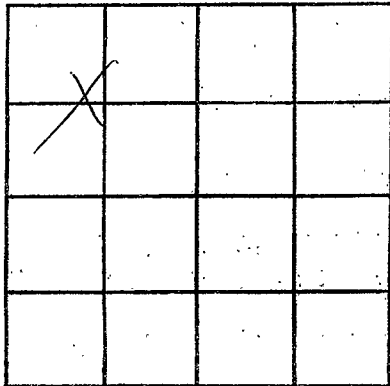

SECTION 26

Please indicate well location X.

ADDITIONAL INFORMATION

If more than one screen,
show locations of each on sketch.