

Pike  
 C 2021  
 4/14/77

MISSISSIPPI  
 BOARD OF WATER COMMISSIONERS  
 416 North State Street  
 Jackson, Mississippi 39201

(32)

WATER WELL DRILLERS LOG

April 15<sup>th</sup> 1977 *Riversville* *Pike*  
 date well completed firm name county well located

LANDOWNER:  
*Douglas Rayborn*  
*At Jayses*  
 (mailing address)

description of formations encountered	from	to
<i>Clay</i>	<i>0</i>	<i>17</i>
<i>Red Sand</i>	<i>17</i>	<i>90</i>
<i>Sand &amp; Gravel</i>	<i>90</i>	<i>100</i>
<i>pink Chalk</i>	<i>100</i>	<i>127</i>
<i>Sand &amp; Gravel</i>	<i>127</i>	<i>140</i>

WELL LOCATION:  
 sec. *11* T. *4* N R. *9* E  
*3 1/2* miles *E-NE* of *Edwards*  
 (distance) (direction) (nearest town)

WELL PURPOSE: *Trailer*  
 (home, irrigation, municipal, industrial)

- WELL COMPLETION DATA:
- (1) diameter (inches) *4"*
  - (2) total depth (feet) *140*
  - (3) static water level (feet) *85* below top of ground.
  - (4) casing *Plastic bottom* (material) (depth)
  - 1* if telescope see back. (size)
  - (5) screen *6"* *134'* (length) (depth to top)
  - 4"* *Plastic* (size) (material)
  - (6) pump *1/2 HP* *10* (HP) (yield gpm)
  - elect* (type power)
  - (7) electric log *no* (yes or no)
  - (organization running log)

(8) how well bottom plugged  
*Washed plug*


DRILLERS REMARKS:

RECEIVED  
 AUG 1 1977

MISS. BD. OF WATER COMMISSIONERS

If well telescopes please sketch and show depths.

GROUND LEVEL

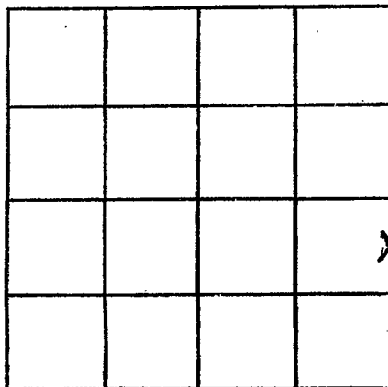

SECTION 11

Please indicate well location X.

ADDITIONAL INFORMATION

If more than one screen, show locations of each on sketch.