

Pike  
C 2002  
4-25-77

MISSISSIPPI  
 BOARD OF WATER COMMISSIONERS  
 416 North State Street  
 Jackson, Mississippi 39201

1324

WATER WELL DRILLERS LOG

4-25 1977 Artquell Oil Field Pike  
 date well completed firm name county well located

LANDOWNER:	description of formations encountered	from	to
<u>Spring Branch Church</u>			
<u>RR. Jones</u> (mailing address)	<u>Red clay</u>	<u>0</u>	<u>20</u>
	<u>Red sand</u>	<u>20</u>	<u>130</u>
	<u>Coarse sand &amp; gravel</u>	<u>130</u>	<u>140</u>
WELL LOCATION:			
sec. <u>9</u> T. <u>4</u> (N) S R. <u>9</u> (E) W			
<u>2</u> miles <u>NE</u> of <u>Felton Campground</u> (distance) (direction) (nearest town)			
WELL PURPOSE:			
<u>Home</u> (home, irrigation, municipal, industrial)			
WELL COMPLETION DATA:			
(1) diameter (inches) <u>4</u>			
(2) total depth (feet) <u>140</u>			
(3) static water level (feet) <u>80</u> below top of ground.			
(4) casing <u>PVC</u> , <u>132</u> (material) (depth)			
<u>4</u> (size) if telescope see back.			
(5) screen <u>8</u> , <u>132</u> (length) (depth to top)			
<u>4</u> , <u>PVC</u> (size) (material)			
(6) pump <u>1/2</u> , <u>10</u> (HP) (yield gpm)			
<u>elec</u> (type power)			
(7) electric log <u>no</u> (yes or no)			
(organization running log)			
(8) how well bottom plugged <u>Seal thick</u>			
DRILLERS REMARKS:			


**RECEIVED**

JUL 5 1977

MISS. BO. OF WATER COMMISSIONERS

If well telescopes please sketch and show depths.

GROUND LEVEL

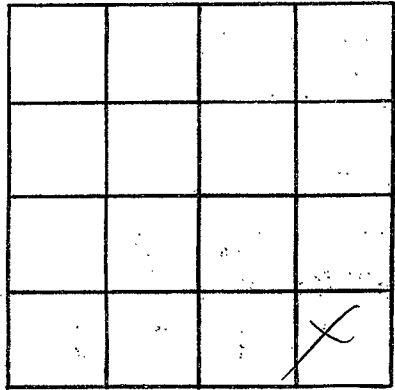

SECTION 9

Please indicate well location X.

ADDITIONAL INFORMATION

If more than one screen, show locations of each on sketch.