

PIKE
 C 2004
 8-4-77

MISSISSIPPI
 BOARD OF WATER COMMISSIONERS
 416 North State Street
 132 Jackson, Mississippi 39201

WATER WELL DRILLERS LOG

8-4 date well completed 19 77 Fitzgerald Well Seal firm name Pike county well located

LANDOWNER:	description of formations encountered	from	to
Paul Hays			
RB Summit Miss (mailing address)	Red Sand	20	150
	Coarse Sand & Gravel	150	168

WELL LOCATION:
 sec. 19 T 90N 4 S R 4E
 1 miles W of Felders
 (distance) (direction) (nearest town)

WELL PURPOSE: Home
 (home, irrigation, municipal, industrial)

- WELL COMPLETION DATA:
- (1) diameter (inches) 4
 - (2) total depth (feet) 168
 - (3) static water level (feet) 120 below top of ground.
 - (4) casing PVC 160 (material) (depth)
 4 (size) if telescope see back.
 - (5) screen 8 160 (length) (depth to top)
 4 (size) PVC (material)
 - (6) pump 1 20 (HP) (yield gpm)
 Elec (type power)
 - (7) electric log no (yes or no)
 (organization running log)
 - (8) how well bottom plugged Sand/blk


RECEIVED
 AUG 29 1977

DRILLERS REMARKS:

MISS. BD. OF WATER COMMISSIONERS

If well telescopes please sketch and show depths.

GROUND LEVEL

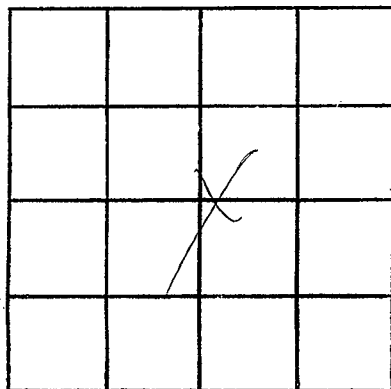

SECTION 19

Please indicate well location X.

ADDITIONAL INFORMATION

Lined area for additional information.

If more than one screen, show locations of each on sketch.