

Pike  
 C 2005  
 12/16/77

MISSISSIPPI  
 BOARD OF WATER COMMISSIONERS  
 416 North State Street  
 Jackson, Mississippi 39201

WATER WELL DRILLERS LOG

12-16-77 27 Floyd Well Serv Pike  
 date well completed firm name county well located

LANDOWNER:  
Albert Baker  
R.R. Summit, Ms.  
 (mailing address)

description of formations encountered	from	to
<u>Red clay</u>	<u>0</u>	<u>20</u>
<u>Red sand</u>	<u>20</u>	<u>40</u>
<u>Coarse sand &amp; gravel</u>	<u>40</u>	<u>73</u>

WELL LOCATION:  
 sec. 9 T. 4 N. R. 9 E  
11 miles E of Mcab  
 (distance) (direction) (nearest town)

WELL PURPOSE: Home  
 (home, irrigation, municipal, industrial)

- WELL COMPLETION DATA:
- (1) diameter (inches) 4
  - (2) total depth (feet) 73
  - (3) static water level (feet) 40 below above top of ground.
  - (4) casing P.O.C. 65  
 (material) (depth)  
4 if telescope see back.  
 (size)
  - (5) screen 8 65  
 (length) (depth to top)  
4 P.O.C.  
 (size) (material)
  - (6) pump 1HP 25  
 (HP) (yield gpm)  
EL  
 (type power)
  - (7) electric log no  
 (yes or no)  
 (organization running log)
  - (8) how well bottom plugged. Seal OK


DRILLERS REMARKS:

RECEIVED  
 DEC 28 1977

MISS. BD. OF WATER COMMISSIONERS

If well telescopes please sketch and show depths.

GROUND LEVEL

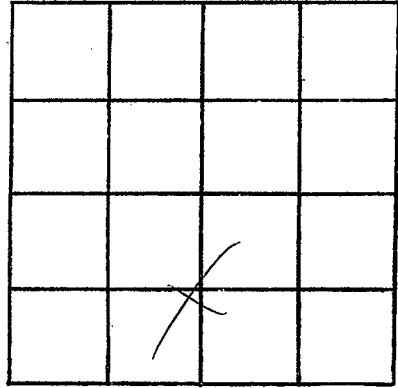

SECTION 9

Please indicate well location X.

ADDITIONAL INFORMATION

If more than one screen,  
show locations of each on sketch.