

PIKE

MISSISSIPPI
BOARD OF WATER COMMISSIONERS
416 North State Street
Jackson, Mississippi 39201

WATER WELL DRILLERS LOG

2026^C
3-7-78

3-7-78 date well completed 19 78 Fitzgerald Well Serv firm name Pike county well located

LANDOWNER:
Danny Easley
P.O. Summit, MS
(mailing address)

description of formations encountered	from	to
Red clay	0	20
Red sand	20	80
Red gravel	80	105
Coarse sand & gravel	105	118

WELL LOCATION:
sec. 7 T. 4(N) R. 9(E)
2 miles N of Fellers
(distance) (direction) (nearest town)

WELL PURPOSE: Home
(home, irrigation, municipal, industrial)


- WELL COMPLETION DATA:
- (1) diameter (inches) 4
 - (2) total depth (feet) 118
 - (3) static water level (feet) 84 below top of ground.
 - (4) casing PVC 110 (material) (depth)
4 (size) If telescope see back.
 - (5) screen 8 110 (length) (depth to top)
4 (size) PVC (material)
 - (6) pump 1/2 60 (HP) (yield gpm)
Elex (type power)
 - (7) electric log ne (yes or no)
 - (8) how well bottom plugged Sandstone

DRILLERS REMARKS:

RECEIVED
APR 27 1978

If well telescopes please sketch and show depths.

GROUND LEVEL

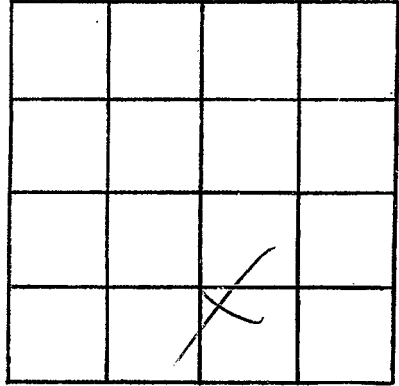

SECTION 7

Please indicate well location X.

ADDITIONAL INFORMATION

If more than one screen,
show locations of each on sketch.