

PIKE  
 2028C  
 6/6/78

MISSISSIPPI  
 BOARD OF WATER COMMISSIONERS  
 416 North State Street  
 Jackson, Mississippi 39201

WATER WELL DRILLERS LOG

6-6 1978 Flanagan Well Serv Pike  
 date well completed firm name county well located

LANDOWNER: Floyd Jackson  
R.R. Johnson  
 (mailing address)

description of formations encountered

from to

Red clay 0 20  
Coarse sand & silt of gravel 20 ~~118~~ 126

WELL LOCATION:  
 sec. 10 T 4 N R 9 E  
4 miles N of Prichard  
 (distance) (direction) (nearest town)

WELL PURPOSE: Home  
 (home, irrigation, municipal, industrial)

- WELL COMPLETION DATA:
- (1) diameter (inches) 4
  - (2) total depth (feet) 126
  - (3) static water level (feet) 85 below top of ground
  - (4) casing PVC 118  
 (material) (depth)
  - 4 if telescope see back.  
 (size)
  - (5) screen 8 118  
 (length) (depth to top)
  - 4 PVC  
 (size) (material)
  - (6) pump 1/2 10  
 (HP) (yield gpm)
  - Electric  
 (type power)
  - (7) electric log No  
 (yes or no)
  - Flanagan Well Serv  
 (organization running log)
  - (8) how well bottom plugged Sealed

DRILLERS REMARKS:


RECEIVED

JUN 23 1978

MISS. BD. OF WATER COMMISSIONERS

If well telescopes please sketch and show depths.

GROUND LEVEL

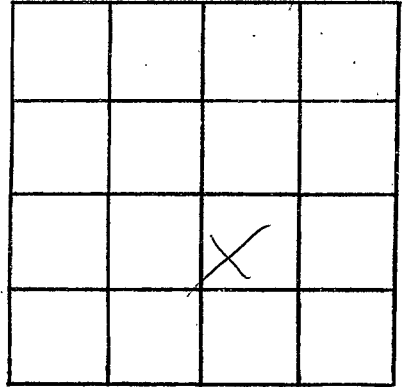

SECTION 10

Please indicate well location X.

ADDITIONAL INFORMATION

If more than one screen,  
show locations of each on sketch.