

PIKE  
 C 202A  
 5/6/78

MISSISSIPPI  
 BOARD OF WATER COMMISSIONERS  
 416 North State Street  
 Jackson, Mississippi 39201

WATER WELL DRILLERS LOG

May 6 1978 Bevers Well Ser. Pike  
 date/well completed firm name county well located

LANDOWNER:	description of formations encountered	from	to
<u>Henny Coon</u> <u>Rt Summit</u> (mailing address)	<u>Red sandy Clay</u> <u>Red sand</u> <u>Shells</u> <u>Coarser sand</u>	<u>0</u> <u>25</u> <u>70</u> <u>110</u>	<u>25</u> <u>70</u> <u>110</u> <u>131</u>
WELL LOCATION: sec. <u>15</u> T <u>4</u> N R <u>9</u> E <u>2</u> miles <u>North</u> of <u>Priceville</u> (distance) (direction) (nearest town)			
WELL PURPOSE: <u>home</u> (home, irrigation, municipal, industrial)			
WELL COMPLETION DATA:			
(1) diameter (inches) <u>4"</u>			
(2) total depth (feet) <u>131</u>			
(3) static water level (feet) <u>95</u> below top of ground.			
(4) casing <u>plastic bottom</u> (material) (depth)			
_____ if telescope see back. (size)			
(5) screen <u>5'</u> <u>126'</u> (length) (depth to top)			
_____ <u>plastic</u> (size) (material)			
(6) pump <u>2 1/2</u> <u>10</u> (HP) (yield gpm)			
_____ <u>electric</u> (type power)			
(7) electric log <u>no</u> (yes or no)			
_____ (organization running log)			
(8) how well bottom plugged _____			
DRILLERS REMARKS: <u>Wooden plug</u>			


RECEIVED

JUN 26 1978

MISS. BD. OF WATER COMMISSIONERS

If well telescopes please sketch and show depths.

GROUND LEVEL

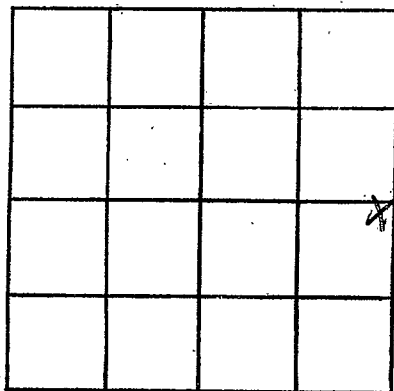

SECTION 15

Please indicate well location X.

ADDITIONAL INFORMATION

If more than one screen,  
show locations of each on sketch.