

PIKE
 C 2030
 7-26-78

MISSISSIPPI
 BOARD OF WATER COMMISSIONERS
 416 North State Street
 Jackson, Mississippi 39201

WATER WELL DRILLERS LOG

7-26-1978 date well completed
 Ft. Campbell Well Serv. Co. firm name
 Pike county well located

LANDOWNER: Hattie Denaway
R.R. Johnson
 (mailing address)

description of formations encountered	from	to
Red clay	0	20
Red ground	20	80
white chert	80	120
Coarse sand & gravel	120	130

WELL LOCATION:
 sec. 3 T. 4 N. R. 9 E
5 miles N off Pinckel
 (distance) (direction) (nearest town)

WELL PURPOSE: Home
 (home, irrigation, municipal, industrial)


- WELL COMPLETION DATA:
- (1) diameter (inches) 4
 - (2) total depth (feet) 130
 - (3) static water level (feet) 90 below above top of ground.
 - (4) casing PVC 122
 (material) (depth)
4 If telescope see back.
 (size)
 - (5) screen 8 122
 (length) (depth to top)
4 PVC
 (size) (material)
 - (6) pump 1/2 10
 (HP) (yield gpm)
Electric
 (type power)
 - (7) electric log no
 (yes or no)
South
 (organization running log)
 - (8) how well bottom plugged South

DRILLERS REMARKS:

RECEIVED
 AUG 24 1978

If well telescopes please sketch and show depths.

GROUND LEVEL

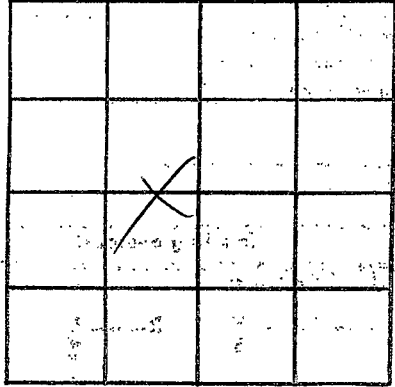

SECTION 3

Please indicate well location X:

ADDITIONAL INFORMATION

If more than one screen, show locations of each on sketch.