

PIKE
C 2033
6-14-78

**MISSISSIPPI  
BOARD OF WATER COMMISSIONERS**  
416 North State Street  
Jackson, Mississippi 39201

**WATER WELL DRILLERS LOG**

June 14 1978 Reams Well in Pike  
 date well completed                      firm name                      county well located

**LANDOWNER:**  
Mr. Alton Alexander  
Rt Summit  
 (mailing address)

description of formations encountered	from	to
<u>Red Clay</u>	<u>0</u>	<u>22</u>
<u>Red sandstone</u>	<u>22</u>	<u>80</u>
<u>limestone</u>	<u>80</u>	<u>100</u>
<u>sand &amp; gravel</u>	<u>100</u>	<u>115</u>

**WELL LOCATION:**  
 sec 28 T 4 N R 9 E  
1 miles West of presidents  
 (distance) (direction) (nearest town)

**WELL PURPOSE:** home  
 (home, irrigation, municipal, industrial)

- WELL COMPLETION DATA:**
- (1) diameter (inches) 4"
  - (2) total depth (feet) 115
  - (3) static water level (feet) 102 below top of ground
  - (4) casing plastic (material) bottom (depth)
  - \_\_\_\_\_ If telescope see back. (size)
  - (5) screen 5' (length) 110' (depth to top)
  - 4" (size) plastic (material)
  - (6) pump 1/2 HP (HP) 10 (yield gpm)
  - elect (type power)
  - (7) electric log no (yes or no)
  - \_\_\_\_\_ (organization running log)

(8) how well bottom plugged wood plug


DRILLERS REMARKS:  
[Signature]

**RECEIVED**  
 OCT 25 1978

MISS. BD. OF WATER COMMISSIONERS

If well telescopes please sketch and show depths.

GROUND LEVEL

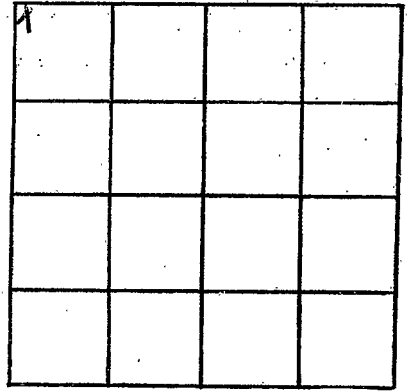

SECTION 28

Please indicate well location X.

ADDITIONAL INFORMATION

If more than one screen,  
show locations of each on sketch.