

PIKE

C 2035

7-29-78

MISSISSIPPI  
 BOARD OF WATER COMMISSIONERS  
 416 North State Street  
 Jackson, Mississippi 39201

WATER WELL DRILLERS LOG

July 29 1978 Rausmiller Pike  
 date well completed firm name county well located

LANDOWNER: Ross Howell  
 Rt. 1 Jayess  
 (mailing address)

description of formations encountered	from	to
Clay sand	0	25
Red sand	25	60
Sabbell	60	95
Gravel sand	95	120


WELL LOCATION:  
 sec. 23 T 7N R 9E  
1 miles East of Priceville  
 (distance) (direction) (nearest town)

WELL PURPOSE: Trailer  
 (home, irrigation, municipal, industrial)

- WELL COMPLETION DATA:
- (1) diameter (inches) 4"
  - (2) total depth (feet) 120
  - (3) static water level (feet) 78 below  
top of ground.
  - (4) casing Aluma bottom  
(material) (depth)  
6 If telescope see back.  
(size)
  - (5) screen 5' 115'  
(length) (depth to top)  
10" Aluma  
(size) (material)
  - (6) pump 1/2 HP 100  
(HP) (yield gpm)  
shot  
(type power)
  - (7) electric log no  
(yes or no)
- (organization running log)

(8) how well bottom plugged  
wooden plug


DRILLERS REMARKS:  
[Signature]

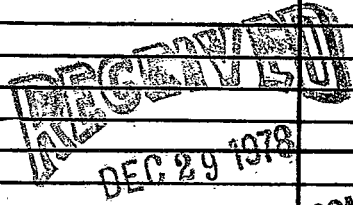

MISS. BD. OF WATER COMM.

If well telescopes please sketch and show depths.

GROUND LEVEL

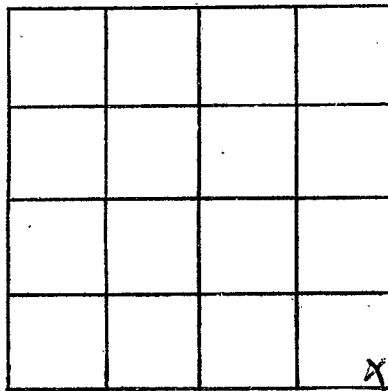

SECTION 23

Please indicate well location X.

ADDITIONAL INFORMATION

If more than one screen, show locations of each on sketch.