

Pike
 C 203e
 May 10, 1979

MISSISSIPPI
 BOARD OF WATER COMMISSIONERS
 416 North State Street
 Jackson, Mississippi 39201

WATER WELL DRILLERS LOG

5-10 1979 *Fitzgerald Well Service* *Pike*
 date well completed firm name county well located

LANDOWNER:
Alchie Bayard
B.B. Jones, Jr.
 (mailing address)

description of formations encountered	from	to
<i>Red Clay</i>	<i>0</i>	<i>20</i>
<i>Coarse sandstone</i>	<i>20</i>	<i>128</i>

WELL LOCATION:
 sec. 3 T. 4 N. R. 9 E
5 miles A of Preville
 (distance) (direction) (nearest town)

WELL PURPOSE:
Home
 (home, irrigation, municipal, industrial)

- WELL COMPLETION DATA:
- (1) diameter (inches) 4
 - (2) total depth (feet) 128
 - (3) static water level (feet) 90 below above top of ground.
 - (4) casing PVC, 120,
 (material) (depth)
4 if telescope see back.
 (size)
 - (5) screen 8, 120
 (length) (depth to top)
4, PVC
 (size) (material)
 - (6) pump 1/2, 10
 (HP) (yield gpm)
Elea
 (type power)
 - (7) electric log yes (yes or no)
 - (organization running log) Landfill
 - (8) how well bottom plugged Landfill

DRILLERS REMARKS:


Miss. Board of Water Comm.

JUL 17 1979

RECEIVED
 RECEIVED

If well telescopes please sketch and show depths.

GROUND LEVEL

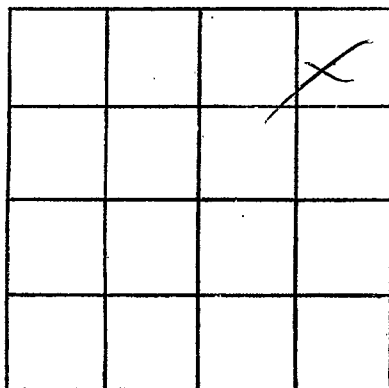

SECTION 3

Please indicate well location X.

ADDITIONAL INFORMATION

If more than one screen,
show locations of each on sketch.