

Pike  
 02057  
 3/8/79

MISSISSIPPI  
 BOARD OF WATER COMMISSIONERS  
 416 North State Street  
 Jackson, Mississippi 39201

WATER WELL DRILLERS LOG

3-8 1979 date well completed  
 Fitchell well drill firm name  
 Pike county well located

LANDOWNER:

Dr. Powell -  
 R.R. Secant - Mrs.  
 (mailing address)

description of formations encountered

from to

Red clay	0	20
Red sand	20	90
Red gravel	90	150
Coarse sand & gravel	150	180

WELL LOCATION:

sec. 19 T. 4 N. R. 9 E  
 1 miles W of W. J. Hall  
 (distance) (direction) of (nearest town)

WELL PURPOSE:

Home (home, irrigation, municipal, industrial)

WELL COMPLETION DATA:

- (1) diameter (inches) 4-4
- (2) total depth (feet) 180-163
- (3) static water level (feet) 110-16 below top of ground.
- (4) casing PVC 172-155 (material) (depth)  
 4 (size) If telescope see back.
- (5) screen 8 172-155 (length) (depth to top)  
 4 (size) PVC (material)
- (6) pump 1 18 (HP) (yield gpm)  
 Elec (type power)
- (7) electric log No (yes or no)

(Organization running log)

- (8) how well bottom plugged Seal RR

DRILLERS REMARKS:


Miss. Board of Water Comm.

MAR 28 1979

RECEIVED

If well telescopes please sketch and show depths.

GROUND LEVEL

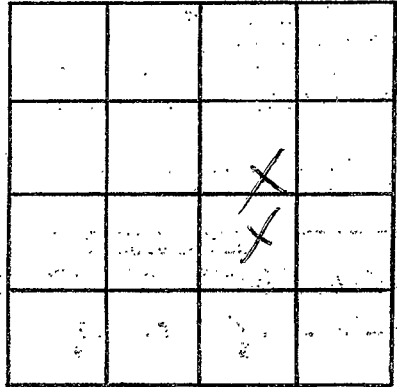

SECTION 19

Please indicate well location X.

ADDITIONAL INFORMATION

If more than one screen, show locations of each on sketch.