

Pike
 C 205
 3/20/79

MISSISSIPPI
 BOARD OF WATER COMMISSIONERS
 416 North State Street
 Jackson, Mississippi 39201

WATER WELL DRILLERS LOG

March 20 1979 *Reems Miller* *Pike*
 date well completed firm name county well located

LANDOWNER:
Bill Jones
Rt Summit
 (mailing address)

description of formations encountered	from	to
<i>Blue</i>	<i>0</i>	<i>15</i>
<i>pink chert</i>	<i>15</i>	<i>25</i>
<i>Sand</i>		
<i>Chert</i>	<i>25</i>	<i>80</i>
<i>Red sand</i>	<i>80</i>	<i>104</i>
<i>pink chert</i>	<i>104</i>	<i>122</i>
<i>Coarse sand</i>	<i>122</i>	<i>143</i>

WELL LOCATION:
 sec *20* T *4* N R *9* E
3 miles *W. NW* of *Price*
 (distance) (direction) (nearest town)

WELL PURPOSE: *home*
 (home, irrigation, municipal, industrial)

- WELL COMPLETION DATA:
- (1) diameter (inches) *4"*
 - (2) total depth (feet) *143*
 - (3) static water level (feet) *112'* below top of ground.
 - (4) casing *plastic* (material) *bottom* (depth)
 - if telescope see back. (size)
 - (5) screen *5* (length) *138'* (depth to top)
 - 4"* (size) *plastic* (material)
 - (6) pump *sub* (HP) *10* (yield gpm)
 - sub* (type power)
 - (7) electric log *no* (yes or no)
 - (organization running log)

(8) how well bottom plugged
made plug

DRILLERS REMARKS:
[Signature]


Miss. Board of Water Comm.

JUN 18 1979

RECEIVED

If well telescopes please sketch and show depths.

GROUND LEVEL

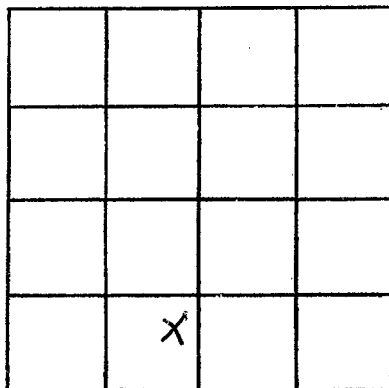

SECTION 20

Please indicate well location X.

ADDITIONAL INFORMATION

If more than one screen,
show locations of each on sketch.