

Pike  
C 2040

MISSISSIPPI  
BOARD OF WATER COMMISSIONERS  
416 North State Street  
Jackson, Mississippi 39201

5-15-79

WATER WELL DRILLERS LOG

May 15 1979 99 Rivers Well Co Pike  
date well completed firm name county well located

LANDOWNER:  
Larry Raybon  
Rt Jayess  
(mailing address)

description of formations encountered	from	to
<u>Red Clay</u>	<u>0</u>	<u>27</u>
<u>Red sand</u>	<u>27</u>	<u>96</u>
<u>Gravel</u>	<u>96</u>	<u>125</u>
<u>Clay</u>	<u>105</u>	<u>125</u>
<u>Gravelly sand</u>	<u>125</u>	<u>142</u>

WELL LOCATION:  
sec 23 T 4 N R 9 E  
#  
2 miles N-NE Priceville  
(distance) (direction) (nearest town)

WELL PURPOSE: Trailer  
(home, irrigation, municipal, industrial)

WELL COMPLETION DATA:

(1) diameter (inches) 4"

(2) total depth (feet) 142

(3) static water level (feet) 90 below top of ground

(4) casing plastic bottom  
(material) (depth)

— if telescope see back.  
(size)

(5) screen 5' 137'  
(length) (depth to top)

4" plastic  
(size) (material)

(6) pump 1/2 10  
(HP) (field gpm)

elect  
(type power)

(7) electric log no  
(yes or no)

—  
(organization running log)

DEPT. OF NATURAL RESOURCES  
BUREAU OF LAND & WATER RESOURCES

OCT 19 1979


RECEIVED

(8) how well bottom plugged  
wood-plug

DRILLERS REMARKS:  
all well ruined  
by lightning

If well telescopes please sketch and show depths.

GROUND LEVEL

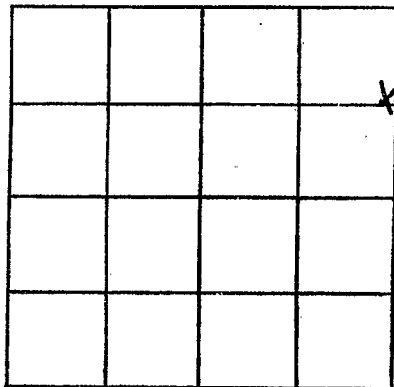

SECTION 33

Please indicate well location X.

ADDITIONAL INFORMATION

If more than one screen,  
show locations of each on sketch.