

MISS.
BOARD OF WATER COMMISSIONERS
416 North State Street
Jackson, Mississippi 39201

PIKE
C. 2044
8-27-79
Aug. 27 1979
date well completed

WATER WELL DRILLERS LOG

1979 Acas well Ser. Pike
firm name county well located

LANDOWNER:
Richard Morgan
Rt. Summit
(mailing address)

description of formations encountered	from to	
<u>Red sandy clay</u>	<u>9</u>	<u>17</u>
<u>Red sand</u>	<u>17</u>	<u>53</u>
<u>Chalky latite</u>	<u>53</u>	<u>98</u>
<u>Small gravel</u>	<u>98</u>	<u>112</u>
<u>4' sand</u>		

WELL LOCATION:
sec. 21 T4 N R 9 E
3 miles north of Prichard
(distance) (direction) (nearest town)

WELL PURPOSE: home
(home, irrigation, municipal, industrial)

WELL COMPLETION DATA:

(1) diameter (inches) 4"

(2) total depth (feet) 112

(3) static water level (feet) 65 ^{below} / _{above} top of ground.

(4) casing plastic bottom
(material) (depth)

If telescope see back.
(size)

(5) screen 5' 107'
(length) (depth to top)

4"
(size) (material) plastic

(6) pump 2 1/2 hp 10
(HP) (yield gpm)

elect
(type power)

(7) electric log no
(yes or no)

(organization running log)

(8) how well bottom plugged:
wood plug

DRILLERS REMARKS:
[Signature]


DEPT. OF NATURAL RESOURCES
BUREAU OF LAND & WATER RESOURCES

JUN 25 1980

RECEIVED

If well is
sketch and show depths.

GROUND LEVEL

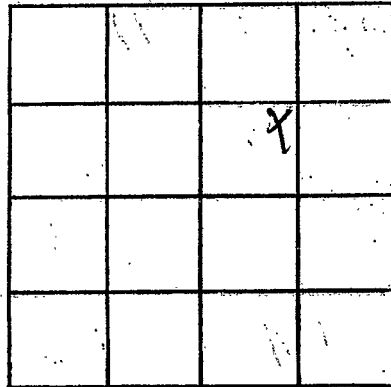

SECTION 21

Please indicate well location X.

ADDITIONAL INFORMATION

If more than one screen,
show locations of each on sketch.