

Pike  
C 2045  
2-7-80

MISSISSIPPI  
 BOARD OF WATER COMMISSIONERS  
 416 North State Street  
 Jackson, Mississippi 39201

WATER WELL DRILLERS LOG

2-7-1980 date well completed Fitzgerald Well Dr firm name Pike county well located

LANDOWNER:

Marion Downing

R-R 1 Jowers  
 (mailing address)

WELL LOCATION:

sec. 21 T. 4 N. R. 9 E.  
                     S                    W  
1 miles N of Fucedale  
 (distance) (direction) (nearest town)

WELL PURPOSE:

Home  
(home, irrigation, municipal, industrial)

WELL COMPLETION DATA:

- (1) diameter (inches) 4
- (2) total depth (feet) 128
- (3) static water level (feet) 80 below  
top of ground.
- (4) casing PVC, 120,  
(material) (depth)  
4 if telescope see back.  
(size)
- (5) screen 8, 120  
(length) (depth to top)  
4, PVC  
(size) (material)
- (6) pump 1/2, 10  
(HP) (yield gpm)  
elec  
(type power)
- (7) electric log No  
(yes or no)  
(organization running log)
- (8) how well bottom plugged for 1 blk

description of formations encountered

from to

<u>Red clay</u>	<u>0</u>	<u>20</u>
<u>Red sand</u>	<u>20</u>	<u>80</u>
<u>Red chalk</u>	<u>80</u>	<u>110</u>
<u>Coarse sand &amp; gravel</u>	<u>110</u>	<u>128</u>

DRILLERS REMARKS:


DEPT. OF NATURAL RESOURCES  
BUREAU OF LAND & WATER RESOURCES

MAR 25 1980

RECEIVED

If well telescopes please sketch and show depths.

GROUND LEVEL

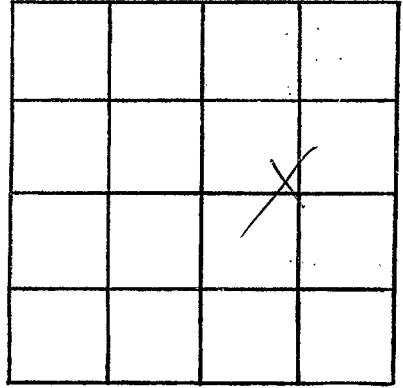

SECTION 21

Please indicate well location X.

ADDITIONAL INFORMATION

If more than one screen, show locations of each on sketch.