

PIKE
C 2040
2-21-80

MISSISSIPPI
 BOARD OF WATER COMMISSIONERS
 416 North State Street
 Jackson, Mississippi 39201


WATER WELL DRILLERS LOG

2-21 19 80 Fitzgerald Well Dr Pike
 date well completed firm name county well located

LANDOWNER:	description of formations encountered	from	to
<u>Willie Paul Buster</u>	<u>Red clay</u>	<u>0</u>	<u>20</u>
<u>R.R. Jayess</u> (mailing address)	<u>Red sand & clay</u>	<u>20</u>	<u>100</u>
WELL LOCATION: sec. <u>2</u> T <u>4</u> N R <u>9</u> E S W <u>5</u> miles <u>N.</u> of <u>Pucedale</u> (distance) (direction) (nearest town)	<u>Coarse sand & gravel</u>	<u>100</u>	<u>115</u>
WELL PURPOSE: <u>Home</u> (home, irrigation, municipal, industrial)			
WELL COMPLETION DATA: (1) diameter (inches) <u>4</u> (2) total depth (feet) <u>115</u> (3) static water level (feet) <u>75</u> below above top of ground. (4) casing <u>PVC</u> , <u>107</u> , (material) (depth) <u>4</u> (size) If telescope see back. (5) screen <u>8</u> , <u>107</u> (length) (depth to top) <u>4</u> , <u>PVC</u> (size) (material) (6) pump <u>1/2</u> , <u>10</u> (HP) (yield gpm) <u>also</u> (type power) (7) electric log <u>no</u> (yes or no) (organization running log) (8) how well bottom plugged <u>fairly well</u>			
DRILLERS REMARKS:	DEPT. OF NATURAL RESOURCES BUREAU OF LAND & WATER RESOURCES MAR 25 1980 RECEIVED		

If well telescopes please sketch and show depths.

GROUND LEVEL

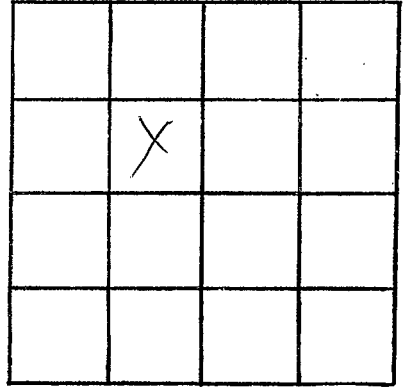

SECTION 2

Please indicate well location X.

ADDITIONAL INFORMATION

If more than one screen,
show locations of each on sketch.