

Pike
 C. 2047
 5-29-80

MISSISSIPPI
 BOARD OF WATER COMMISSIONERS
 416 North State Street
 Jackson, Mississippi 39201

WATER WELL DRILLERS LOG

5-29
 date well completed

1980 F. Bullard, Inc. S.W. Pike
 firm name

county well located

LANDOWNER:

Bill Myers

R.H. Jones
 (mailing address)

description of formations encountered

from to

Red Clay	0	20
Red sand & gravel	20	115
Coarse sand & gravel	115	128

WELL LOCATION:

sec. 10 T. 4 (N) R. 9 (E)
 S W
 f miles N of Pinedale
 (distance) (direction) (nearest town)

WELL PURPOSE:

Home
 (home, irrigation, municipal, industrial)

WELL COMPLETION DATA:

- diameter (inches) 4
- total depth (feet) 128
- static water level (feet) 95 below top of ground.
- casing PVC, 120 (material) (depth)
 4 (size) if telescope see back.
- screen 8 (length), 120 (depth to top)
 4 (size), PVC (material)
- pump 1/2 (HP), 60 (yield gpm)
 Elec (type power)
- electric log No (yes or no)
 (organization running log)
- how well bottom plugged Sand/blk

DEPT. OF NATURAL RESOURCES
 BUREAU OF LAND & WATER RESOURCES


JUN 20 1980

RECEIVED

DRILLERS REMARKS:

If well telescopes please sketch and show depths.

GROUND LEVEL

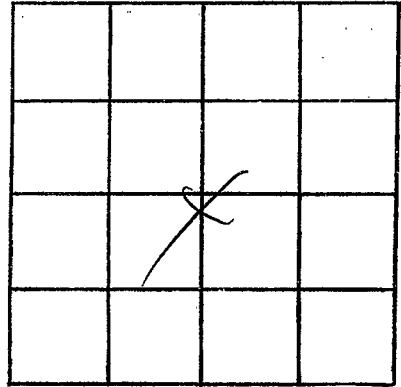

SECTION 10

Please indicate well location X.

ADDITIONAL INFORMATION

If more than one screen, show locations of each on sketch.