

PIKE  
C 2049  
10-14-80

Bureau of Land and Water Resources  
Southport Mall  
P.O. Box 10631  
Jackson, Mississippi 39209  
WATER WELL DRILLERS LOG

12

Oct 14 1980 Newer Miller Pike  
date well completed firm name county well located


LANDOWNER:  
Joe Blairlock  
At Summit  
(mailing address)

description of formations encountered	from	to
<u>Red Clay</u>	<u>0</u>	<u>16</u>
<u>Red sand</u>	<u>16</u>	<u>30</u>
<u>pink Chalk</u>	<u>30</u>	<u>36</u>
<u>sand &amp; small gravel</u>	<u>36</u>	<u>75</u>
<u>blue Chalk</u>	<u>75</u>	<u>115</u>
<u>fine gravel &amp; sand</u>	<u>115</u>	<u>152</u>

WELL LOCATION:  
sec. 20 T 4 N R 9 E  
2 miles west of Summit  
(distance) (direction) (nearest town)

WELL PURPOSE: home  
(home, irrigation, municipal, industrial)


- WELL COMPLETION DATA:
- (1) diameter (inches) 4 1/2
  - (2) total depth (feet) 152
  - (3) static water level (feet) 115 below/above top of ground.
  - (4) casing plastic bottom (material) (depth)
  - (size) if telescope see back.
  - (5) screen 5' 147' (length) (depth to top)
  - 4" (size) plastic (material)
  - (6) pump 1/2 (HP) 10 (yield gpm)
  - cbet (type power)
  - (7) electric log no (yes or no)
  - (organization running log)
  - (8) how well bottom plugged, backed and valve

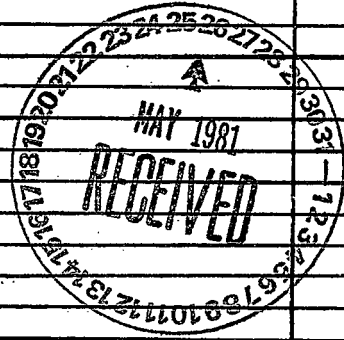

DRILLERS REMARKS:

If well telescopes please sketch and show depths.

GROUND LEVEL

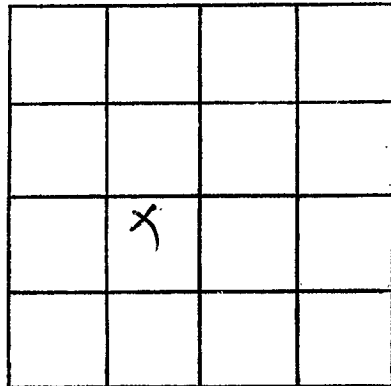

SECTION 20

Please indicate well location X.

ADDITIONAL INFORMATION

If more than one screen,  
show locations of each on sketch.