

MISSISSIPPI DEPARTMENT OF NATURAL RESOURCES

Bureau of Land and Water Resources

Southport Mall

P.O. Box 10631

Jackson, Mississippi 39209

WATER WELL DRILLERS LOG

Pike
C 2051
12-6-80


Dec 6 1980 Purvis Well Co Pike
date well completed firm name county well located

LANDOWNER:	description of formations encountered	from	to
<u>Larry Morgan</u> <u>Rt 2</u> (mailing address)	<u>Red sandy clay</u>	<u>0</u>	<u>27</u>
	<u>Red sand</u>	<u>27</u>	<u>84</u>
	<u>Red gravel</u>	<u>84</u>	<u>115</u>
	<u>pink chalk</u>	<u>115</u>	<u>120</u>
	<u>Red gravel</u>	<u>120</u>	<u>132</u>
	<u>sand</u>		
WELL LOCATION: sec. <u>14</u> T <u>4</u> N R <u>9</u> E <u>2</u> miles <u>south</u> of <u>Priceville</u> (distance) (direction) (nearest town)			
WELL PURPOSE: <u>home</u> (home, irrigation, municipal, industrial)			
WELL COMPLETION DATA:			
(1) diameter (inches) <u>4"</u>			
(2) total depth (feet) <u>132</u>			
(3) static water level (feet) <u>105</u> below above top of ground.			
(4) casing <u>plastic bottom</u> (material) (depth)			
<u>5"</u> If telescope see back. (size)			
(5) screen <u>5'</u> <u>127'</u> (length) (depth to top)			
<u>4"</u> <u>plastic</u> (size) (material)			
(6) pump <u>1/2</u> <u>10</u> (HP) (yield gpm)			
<u>1/2</u> (type power)			
(7) electric log <u>no</u> (yes or no)			
(organization running log)			
(8) how well bottom plugged <u>wooden plug</u>			
DRILLERS REMARKS: <u>✓</u>			



If well telescopes please sketch and show depths.

GROUND LEVEL

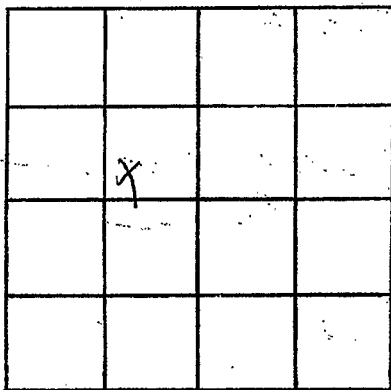

SECTION 14

Please indicate well location X.

ADDITIONAL INFORMATION

If more than one screen,
show locations of each on sketch.