

Pike
C 2052
3-23-81

MISSISSIPPI
BOARD OF WATER COMMISSIONERS
416 North State Street
Jackson, Mississippi 39201

WATER WELL DRILLERS LOG

3-23
date well completed

1981 *Flanagan Well Serv*
firm name

Pike
county well located


LANDOWNER:	description of formations encountered	from	to
<i>Bernard Forrest</i>			
<i>P.R. McComb, Jr.</i> (mailing address)	<i>Keel Clay</i>	<i>0</i>	<i>20</i>
	<i>Red Sand</i>	<i>20</i>	<i>70</i>
	<i>Whitechalk</i>	<i>70</i>	<i>180</i>
	<i>Fine Sand</i>	<i>180</i>	<i>200</i>
	<i>Coarse sand & gravel</i>	<i>200</i>	<i>210</i>
WELL LOCATION: sec. <i>2</i> T <i>4</i> N R <i>9</i> E S W <i>3</i> miles <i>SE</i> of <i>Precedale</i> (distance) (direction) (nearest town)			
WELL PURPOSE: <i>Home</i> (home, irrigation, municipal, industrial)			
WELL COMPLETION DATA:			
(1) diameter (inches) <i>4</i>			
(2) total depth (feet) <i>210</i>			
(3) static water level (feet) <i>140</i> below top of ground. above			
(4) casing <i>PVC, 202</i> , (material) (depth)			
<i>4</i> (size) If telescope see back.			
(5) screen <i>8, 202</i> (length) (depth to top)			
<i>4, PVC</i> (size) (material)			
(6) pump <i>1, 15</i> (HP) (yield gpm)			
<i>elec</i> (type power)			
(7) electric log <i>no</i> (yes or no)			
(organization running log)			
(8) how well bottom plugged <i>bed rock</i>			
DRILLERS REMARKS:			

DEPT. OF NATURAL RESOURCES
BUREAU OF LAND & WATER RESOURCES

APR 29 1981
RECEIVED

If well telescopes please sketch and show depths.

GROUND LEVEL

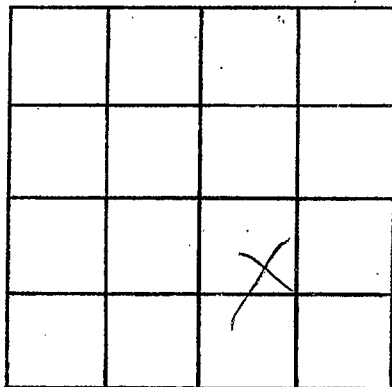

SECTION 2

Please indicate well location X.

ADDITIONAL INFORMATION

If more than one screen, show locations of each on sketch.