


PIKE
C 2053
7-22-81

MISSISSIPPI
 BOARD OF WATER COMMISSIONERS
 416 North State Street
 Jackson, Mississippi 39201

WATER WELL DRILLERS LOG


7-22 1981 Flynn Well Dr Pike
 date well completed firm name county well located

LANDOWNER:	description of formations encountered	from	to
<u>Elmo Ratcliff</u>	<u>Red clay</u>	<u>0</u>	<u>20</u>
<u>R.R. Jones, Jr.</u> (mailing address)	<u>White & Blue cherty</u> <u>limestone & sand</u>	<u>20</u>	<u>135</u> <u>135</u> <u>154</u>
WELL LOCATION:			
sec. <u>23</u> T <u>4</u> N R <u>9</u> E S W <u>1</u> miles <u>N</u> of <u>CARTERSVILLE</u> (distance) (direction) (nearest town)			
WELL PURPOSE: <u>Home</u> (home, irrigation, municipal, industrial)			
WELL COMPLETION DATA:			
(1) diameter (inches) <u>4</u>			
(2) total depth (feet) <u>154</u>			
(3) static water level (feet) <u>95</u> below top of ground.			
(4) casing <u>gal.</u> <u>146</u> (material) (depth)			
<u>4</u> if telescope see back. (size)			
(5) screen <u>8</u> <u>146</u> (length) (depth to top)			
<u>4</u> <u>gal.</u> (size) (material)			
(6) pump <u>1/2</u> <u>20</u> (HP) (yield gpm)			
<u>6kw</u> (type power)			
(7) electric log <u>no</u> (yes or no)			
<u>Flow</u> (organization running log)			
(8) how well bottom plugged <u>L. L. H. K.</u>			
DRILLERS REMARKS:			

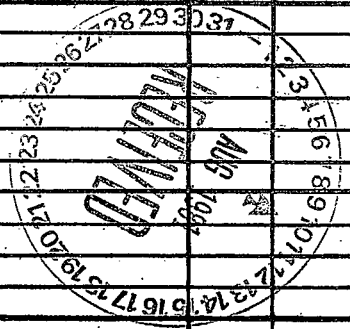

If well telescopes please sketch and show depths.

GROUND LEVEL

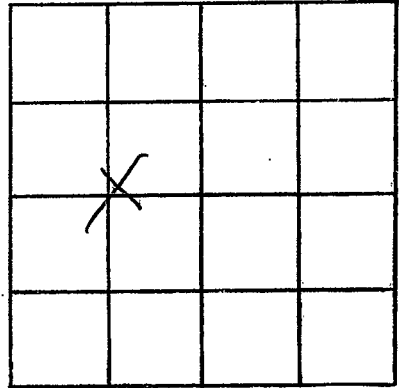

SECTION 23

Please indicate well location X.

ADDITIONAL INFORMATION

If more than one screen,
show locations of each on sketch.