

Pike
C 2054
9-2-81

MISSISSIPPI
 BOARD OF WATER COMMISSIONERS
 416 North State Street
 Jackson, Mississippi 39201

WATER WELL DRILLERS LOG

9-2 1981 Fitzgerald Well Log Pike
 date well completed firm name county well located


| LANDOWNER: | description of formations encountered | from | to |
|--|---------------------------------------|-----------|-----------|
| <u>Evilchie Turner</u> | | | |
| <u>RR 1 Rth ms.</u> (mailing address) | <u>Red clay</u> | <u>0</u> | <u>20</u> |
| | <u>Red gravel</u> | <u>20</u> | <u>80</u> |
| | <u>Coarse sand & gravel</u> | <u>80</u> | <u>96</u> |
| WELL LOCATION: | | | |
| sec. <u>5</u> T. <u>4</u> (N) R. <u>9</u> (E) S W | | | |
| <u>2</u> miles <u>N</u> of <u>Felders</u> (distance) (direction) (nearest town) | | | |
| WELL PURPOSE: <u>Home</u> (home, irrigation, municipal, industrial) | | | |
| WELL COMPLETION DATA: | | | |
| (1) diameter (inches) <u>4</u> | | | |
| (2) total depth (feet) <u>96</u> | | | |
| (3) static water level (feet) <u>78</u> below top of ground. | | | |
| (4) casing <u>PVC</u> , <u>88</u> (material) (depth) | | | |
| <u>4</u> (size) If telescope see back. | | | |
| (5) screen <u>8</u> , <u>88</u> (length) (depth to top) | | | |
| <u>4</u> , <u>PVC</u> (size) (material) | | | |
| (6) pump <u>1/2</u> , <u>10</u> (HP) (yield gpm) | | | |
| (type power) | | | |
| (7) electric log <u>No</u> (yes or no) | | | |
| (organization running log) | | | |
| (8) how well bottom plugged <u>Sand</u> | | | |
| DRILLERS REMARKS: | | | |

81 SEP 30 4:34

RECEIVED

If well telescopes please sketch and show depths.

GROUND LEVEL

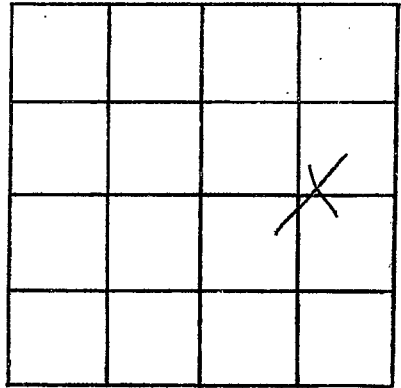

SECTION 5

Please indicate well location X.

ADDITIONAL INFORMATION

If more than one screen,
show locations of each on sketch.