

MISSISSIPPI DEPARTMENT OF NATURAL RESOURCES

Bureau of Land and Water Resources

Southport Mall

P.O. Box 10631


Jackson, Mississippi 39209

WATER WELL DRILLERS LOG

Pike  
C 2055  
4-6-81


April 6 1981 Recess well for Pike  
 date well completed firm name county well located

LANDOWNER:	description of formations encountered	from	to
<u>Doris Burris</u> <u>At Summit</u> (mailing address)			
WELL LOCATION: sec. <u>35</u> T- <u>4</u> N R- <u>9</u> E <u>2</u> miles <u>3-SE</u> of <u>Prichard</u> (distance) (direction) (nearest town)			
WELL PURPOSE: <u>house</u> (home, irrigation, municipal, industrial)			
WELL COMPLETION DATA:			
(1) diameter (inches) <u>4"</u>			
(2) total depth (feet) <u>203</u>			
(3) static water level (feet) <u>112'</u> below top of ground			
(4) casing <u>plastic bottom</u> (material) (depth)			
<u>7</u> if telescope see back. (size)			
(5) screen <u>10'</u> <u>193'</u> (length) (depth to top)			
<u>4"</u> <u>plastic</u> (size) (material)			
(6) pump <u>leg alum</u> (HP) (yield gpm)			
<u>elect</u> (type power)			
(7) electric log <u>no</u> (yes or no)			
<u>—</u> (organization running log)			
(8) how well bottom plugged <u>rock wash</u>			
DRILLERS REMARKS:			

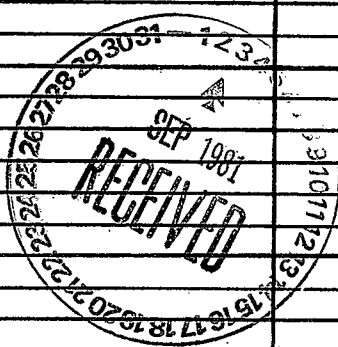

If well telescopes please sketch and show depths.

GROUND LEVEL

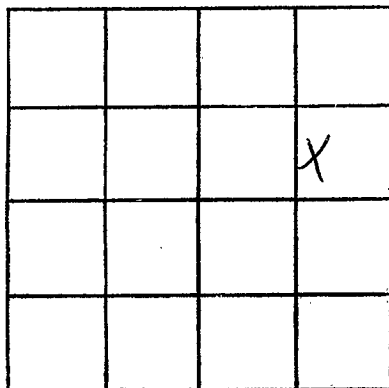

SECTION 35

Please indicate well location X.

ADDITIONAL INFORMATION

If more than one screen,  
show locations of each on sketch.