

MISSISSIPPI DEPARTMENT OF NATURAL RESOURCES

Bureau of Land and Water Resources

Southport Mall

P.O. Box 10631

Jackson, Mississippi 39209

WATER WELL DRILLERS LOG

Pike
C 2056
4-27-81

April 27 1981
 date well completed

Robbie Miller
 firm name

Pike
 county well located

LANDOWNER:
Lonnie Davis
Rt Summit
 (mailing address)

description of formations encountered	from	to
<u>Clay</u>	<u>0</u>	<u>22</u>
<u>sand & clay</u>	<u>22</u>	<u>90</u>
<u>blue chalk</u>	<u>90</u>	<u>165</u>
<u>fine sand</u>	<u>165</u>	<u>180</u>
<u>coarse sand & gravel</u>	<u>180</u>	<u>203</u>

WELL LOCATION:
 sec. 35 T. 4 N. R. 9 E
2 miles S-SE of Priceville
 (distance) (direction) (nearest town)

WELL PURPOSE: home
 (home, irrigation, municipal, industrial)

WELL COMPLETION DATA:

(1) diameter (inches) 4"

(2) total depth (feet) 203

(3) static water level (feet) 110 below above top of ground.

(4) casing plastic bottom
 (material) (depth)

— if telescope see back.
 (size)

(5) screen 10' 193'
 (length) (depth to top)

4" plastic
 (size) (material)

(6) pump 1 sub. 15'
 (HP) (yield gpm)

1/2 hp
 (type power)

(7) electric log no
 (yes or no)

—
 (organization running log)

(8) how well bottom plugged
Bottom good


DRILLERS REMARKS:
—

DEPT. OF NATURAL RESOURCES
 BUREAU OF LAND & WATER RESOURCES

OCT - 1 1981
 RECEIVED

If well telescopes please sketch and show depths.

GROUND LEVEL

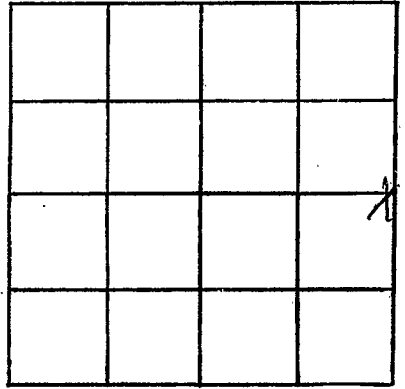

SECTION 35

Please indicate well location X.

ADDITIONAL INFORMATION

If more than one screen, show locations of each on sketch.