

MISSISSIPPI DEPARTMENT OF NATURAL RESOURCES
 Bureau of Land and Water Resources
 Southport Mall
 P.O. Box 10631
 Jackson, Mississippi 39209
 WATER WELL DRILLERS LOG

Pike
 C 2057
 5-31-81

May 31 1981 Pruess Wellen Pike
 date well completed firm name county well located

LANDOWNER:	description of formations encountered	from	to
<u>Radolph Quin</u> <u>Rt 1 M.G. Corab-</u> (mailing address)			
WELL LOCATION: sec. <u>30</u> T <u>4</u> N R <u>9</u> E <u>2</u> miles <u>West</u> of <u>Prichard</u> (distance) (direction) (nearest town)			
WELL PURPOSE: <u>water</u> (home, irrigation, municipal, industrial)			
WELL COMPLETION DATA:			
(1) diameter (inches) <u>4"</u>			
(2) total depth (feet) <u>146</u>			
(3) static water level (feet) <u>110</u> below/above top of ground.			
(4) casing <u>plastic, bottom</u> (material) (depth)			
<u>-</u> If telescope see back. (size)			
(5) screen <u>5'</u> <u>141'</u> (length) (depth to top)			
<u>4"</u> <u>plastic</u> (size) (material)			
(6) pump <u>2 hp</u> <u>10</u> (HP) (yield gpm)			
<u>1 hp</u> (type power)			
(7) electric log <u>no</u> (yes or no)			
<u>-</u> (organization running log)			
(8) how well bottom plugged <u>Backwash</u>			
DRILLERS REMARKS:			


DEPT. OF NATURAL RESOURCES
 BUREAU OF LAND & WATER RESOURCES

NOV 2 - 1981

RECEIVED

If well telescopes please sketch and show depths.

GROUND LEVEL

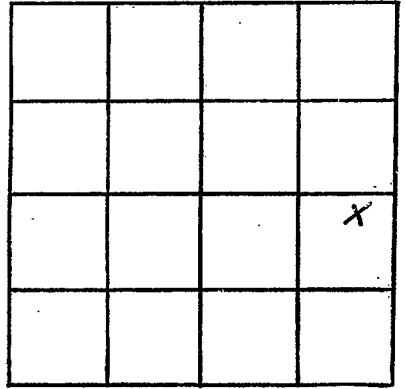

SECTION 30

Please indicate well location X.

ADDITIONAL INFORMATION

If more than one screen,
show locations of each on sketch.