

Pike
C 2058
10-9-81

MISSISSIPPI
BOARD OF WATER COMMISSIONERS
416 North State Street
Jackson, Mississippi 39201

WATER WELL DRILLERS LOG

10-9 1981 Fitzgerald Well Serv Pike
date well completed firm name county well located

LANDOWNER: Junior Abtander
B.R. 1 James, ms.
(mailing address)

description of formations encountered	from	to
<u>Red clay</u>	<u>0</u>	<u>20</u>
<u>Red sand</u>	<u>20</u>	<u>70</u>
<u>Coarse sand & gravel</u>	<u>70</u>	<u>80</u>

WELL LOCATION:
sec 21 T 4 N R 9 E
S W
1/2 miles N of Pineblake
(distance) (direction) (nearest town)

WELL PURPOSE: Home
(home, irrigation, municipal, industrial)

- WELL COMPLETION DATA:
- (1) diameter (inches) 4
 - (2) total depth (feet) 80
 - (3) static water level (feet) 55 below above top of ground.
 - (4) casing PVC, 72,
(material) (depth)
4 if telescope see back.
(size)
 - (5) screen 8, 72
(length) (depth to top)
4, PVC
(size) (material)
 - (6) pump 1/2 10
(HP) (yield gpm)
electric
(type power)
 - (7) electric log no
(yes or no)
(organization running log)
 - (8) how well bottom plugged Seal block

DEPT. OF NATURAL RESOURCES
BUREAU OF LAND & WATER RESOURCES


NOV 20 1981

RECEIVED

DRILLERS REMARKS:

If well telescopes please sketch and show depths.

GROUND LEVEL

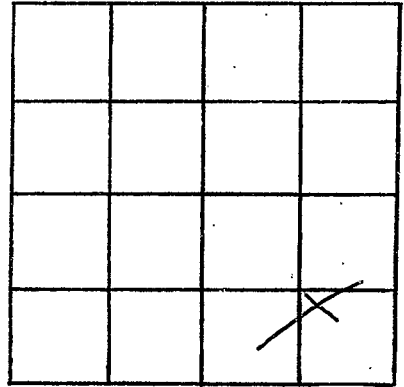

SECTION 31

Please indicate well location X.

ADDITIONAL INFORMATION

If more than one screen,
show locations of each on sketch.