

*Pike*  
*C*  
*2057*

MISSISSIPPI  
 BOARD OF WATER COMMISSIONERS  
 416 North State Street  
 Jackson, Mississippi 39201

WATER WELL DRILLERS LOG

*2-8*

*1982 Fitzgerald Well Co*

*Pike*

date well completed

firm name

county well located

LANDOWNER:

*Mary Ann Boone*

*RR 1 Jayess, ms.*  
 (mailing address)

description of formations encountered

from

to

<i>Red clay</i>	<i>0</i>	<i>20</i>
<i>Red sand</i>	<i>20</i>	<i>95</i>
<i>Coarse sand &amp; gravel</i>	<i>95</i>	<i>126</i>

WELL LOCATION:

sec. *23* T. *4* N. R. *9* E.  
 S W

*2* miles *N* of *Pinedale*  
 (distance) (direction) (nearest town)

WELL PURPOSE:

*Home*  
 (home, irrigation, municipal, industrial)

WELL COMPLETION DATA:

- (1) diameter (inches) *4*
- (2) total depth (feet) *126*
- (3) static water level (feet) *100* below above top of ground.
- (4) casing *PVC, 118*,  
 (material) (depth)  
*4* if telescope see back.  
 (size)
- (5) screen *8, 118*  
 (length) (depth to top)  
*4, PVC*  
 (size) (material)
- (6) pump *1/2, 10*  
 (HP) (yield gpm)  
*Old*  
 (type power)
- (7) electric log *No*  
 (yes or no)

(organization running log)

(8) how well bottom plugged *Sand fill*

DRILLERS REMARKS:


DEPT. OF NATURAL RESOURCES  
 BUREAU OF LAND & WATER RESOURCES

MAR 10 1982

RECEIVED

If well telescopes please sketch and show depths.

GROUND LEVEL

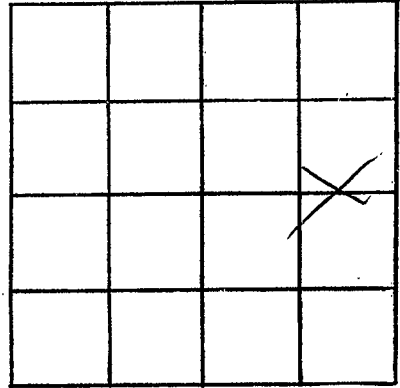

SECTION 22

Please indicate well location X.

ADDITIONAL INFORMATION

If more than one screen, show locations of each on sketch.