

Pike
C
2060

MISSISSIPPI
 BOARD OF WATER COMMISSIONERS
 416 North State Street
 Jackson, Mississippi 39201

WATER WELL DRILLERS LOG

3-27
 date well completed

19*82* *Fitzgerald Well Serv*
 firm name

Pike
 county well located

LANDOWNER:	description of formations encountered	from	to
<i>Barry McDaniel</i> <i>R.R. Summit Mrs.</i> (mailing address)			
WELL LOCATION:			
sec. <i>28</i> T <i>4</i> N R <i>9</i> E S W			
<i>1</i> miles <i>W</i> of <i>Fitzgerald</i> (distance) (direction) (nearest town)			
WELL PURPOSE: <i>Home</i> (home, irrigation, municipal, industrial)			
WELL COMPLETION DATA:			
(1) diameter (inches) <i>4</i>			
(2) total depth (feet) <i>126</i>			
(3) static water level (feet) <i>85</i> below top of ground.			
(4) casing <i>PVC 118</i> (material) (depth)			
<i>4</i> if telescope see back. (size)			
(5) screen <i>8</i> <i>118</i> (length) (depth to top)			
<i>4</i> <i>PVC</i> (size) (material)			
(6) pump <i>1/2</i> <i>60</i> (HP) (yield gpm)			
<i>Electric</i> (type power)			
(7) electric log <i>No</i> (yes or no)			
(organization running log)			
(8) how well bottom plugged <i>Seal plug</i>			
DRILLERS REMARKS:			


DEPT. OF NATURAL RESOURCES
 BUREAU OF LAND & WATER RESOURCES

MAY 25 1982

RECEIVED

If well telescopes please sketch and show depths.

GROUND LEVEL

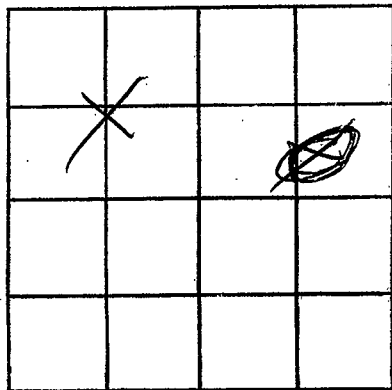

SECTION 28

Please indicate well location X.

ADDITIONAL INFORMATION

If more than one screen, show locations of each on sketch.