

Pike
C 2001

MISSISSIPPI
BOARD OF WATER COMMISSIONERS
416 North State Street
Jackson, Mississippi 39201

WATER WELL DRILLERS LOG

3-29-82 date well completed 19 82 Fitzgerald Well Serv firm name Pike county well located

LANDOWNER:
Albert Thornton
R.R. Roth, Mo.
(mailing address)

description of formations encountered	from	to
Red clay	0	20
Red sand	20	90
Red gravel	90	120
Coarse sand & gravel	120	135

WELL LOCATION:
sec. 6 T 4 N R 9 E
S W
2 miles N of Fellers
(distance) (direction) (nearest town)

WELL PURPOSE: Home
(home, irrigation, municipal, industrial)

- WELL COMPLETION DATA:
- (1) diameter (inches) 4
 - (2) total depth (feet) 135
 - (3) static water level (feet) 90 below top of ground.
 - (4) casing PVC, 127, (material) (depth)
4 (size) if telescope see back.
 - (5) screen 8, 127 (length) (depth to top)
4 (size) PVC (material)
 - (6) pump 1/2 (HP) 10 (yield gpm)
Elec (type power)
 - (7) electric log No (yes or no)
(organization running log)
 - (8) how well bottom plugged Sand blk


DRILLERS REMARKS:

DEPT. OF NATURAL RESOURCES
BUREAU OF LAND & WATER RESOURCES

MAY 25 1982
RECEIVED

If well telescopes please sketch and show depths.

GROUND LEVEL

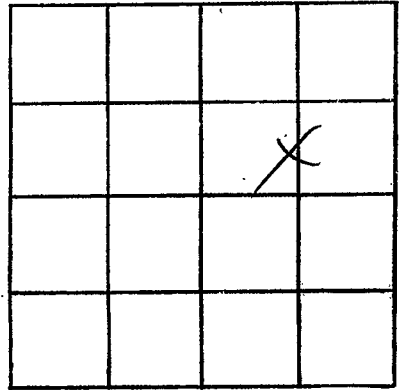

SECTION 6

Please indicate well location X.

ADDITIONAL INFORMATION

If more than one screen,
show locations of each on sketch.