

PIKE
C 2002

MISSISSIPPI
 BOARD OF WATER COMMISSIONERS
 416 North State Street
 Jackson, Mississippi 39201

WATER WELL DRILLERS LOG

5-17 1982 Flywell well Co Pike
 date well completed firm name county well located

LANDOWNER:	description of formations encountered	from	to
<u>Albert Pownels</u> <u>Rh Summit</u> (mailing address)			
WELL LOCATION: sec. <u>19</u> T <u>4</u> N S R <u>9</u> E W of <u>Fallis</u> (distance) (direction) (nearest town)			
WELL PURPOSE: <u>stone</u> (home, irrigation, municipal, industrial)			
WELL COMPLETION DATA:			
(1) diameter (inches) <u>4</u>			
(2) total depth (feet) <u>173</u>			
(3) static water level (feet) <u>120</u> below top of ground.			
(4) casing <u>PVC</u> <u>165</u> (material) (depth)			
<u>4</u> if telescope see back. (size)			
(5) screen <u>8</u> <u>165</u> (length) (depth to top)			
<u>4</u> <u>PVC</u> (size) (material)			
(6) pump <u>3/4</u> <u>15</u> (HP) (yield gpm)			
<u>ela</u> (type power)			
(7) electric log <u>no</u> (yes or no)			
(8) how well bottom plugged <u>Seal</u>			
DRILLERS REMARKS:			


DEPT. OF NATURAL RESOURCES
 BUREAU OF LAND & WATER RESOURCES
 BUREAU OF LAND & WATER RESOURCES

MAY 25 1982
 MAY 2 1982

RECEIVED

If well telescopes please sketch and show depths.

GROUND LEVEL

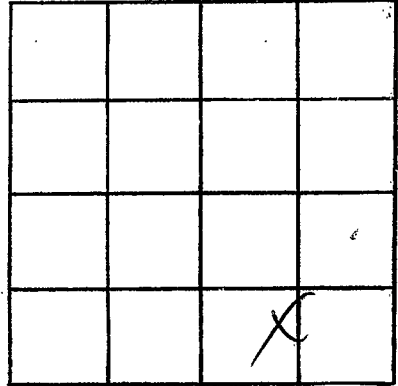

SECTION 19

Please indicate well location X.

ADDITIONAL INFORMATION

If more than one screen,
show locations of each on sketch.