

Fike
C
2003

MISSISSIPPI
 BOARD OF WATER COMMISSIONERS
 416 North State Street
 Jackson, Mississippi 39201

WATER WELL DRILLERS LOG

6-7 19 *82* *Fitzgerald Level Ltd* *Reese*
 date well completed firm name county well located

LANDOWNER:
James Kirby
R.R. Johnson
 (mailing address)

description of formations encountered	from	to
	<i>Red clay</i>	<i>0</i>
<i>Red sand</i>	<i>20</i>	<i>90</i>
<i>White clay</i>	<i>70</i>	<i>147</i>
<i>Coarse sand + gravel</i>	<i>147</i>	<i>160</i>

WELL LOCATION:
 sec *7* *T* *4* N *9* E
 S W
4 miles *NW* of *Pinedale*
 (distance) (direction) (nearest town)

WELL PURPOSE: *Home*
 (home, irrigation, municipal, industrial)

- WELL COMPLETION DATA:
- (1) diameter (inches) *4*
 - (2) total depth (feet) *160*
 - (3) static water level (feet) *90* below
top of ground.
 - (4) casing *PVC*, *152*
(material) (depth)
4 If telescope see back.
(size)
 - (5) screen *8*, *152*
(length) (depth to top)
4, *PVC*
(size) (material)
 - (6) pump *1/2*, *10*
(HP) (yield gpm)
Ela
(type power)
 - (7) electric log *no*
(yes or no)


(8) how well bottom plugged *Sealed*

DRILLERS REMARKS:

DEPT. OF NATURAL RESOURCES
 BUREAU OF LAND & WATER RESOURCES
 JUL -7 1982
RECEIVED

If well telescopes please sketch and show depths.

GROUND LEVEL

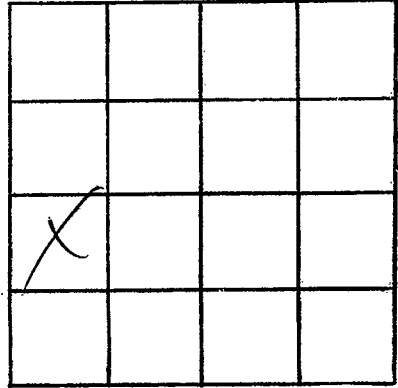

SECTION 2

Please indicate well location X.

ADDITIONAL INFORMATION

If more than one screen, show locations of each on sketch.