

MISSISSIPPI DEPARTMENT OF NATURAL RESOURCES

Bureau of Land and Water Resources

Southport Mall

P.O. Box 10631

Jackson, Mississippi 39209

WATER WELL DRILLERS LOG

PIKE
C 2004

June 21 1982 Recess Well, Pike
date well completed firm name county well located

LANDOWNER:
Dusddy Leah
Rt Summit
(mailing address)

description of formations encountered	from	to
<u>Red Clay</u>	<u>0</u>	<u>15</u>
<u>Red Chalk & shelly</u>	<u>15</u>	<u>60</u>
<u>Gravel & sand</u>	<u>60</u>	<u>85</u>
<u>Chalky loamy</u>	<u>85</u>	<u>100</u>
<u>fine gravel & sand</u>	<u>100</u>	<u>161</u>

WELL LOCATION:
sec. 22 T 4 N R 9 E
1 miles north of Pike Lake
(distance) (direction) (nearest town)

WELL PURPOSE: Trailer
(home, irrigation, municipal, industrial)

WELL COMPLETION DATA:
(1) diameter (inches) 4"
(2) total depth (feet) 161
(3) static water level (feet) 100 below above top of ground.
(4) casing plastic bottom
(material) (depth)
_____ if telescope see back.
(size)
(5) screen 3' 156'
(length) (depth to top)
4" plastic
(size) (material)
(6) pump 1/2 10
(HP) (yield gpm)
elect
(type power)
(7) electric log no
(yes or no)
_____ (organization running log)

(8) how well bottom plugged back wash

DRILLERS REMARKS:
✓


DEPT. OF NATURAL RESOURCES
BUREAU OF LAND & WATER RESOURCES

NOV 22 1982

RECEIVED

If well telescopes please
sketch and show depths.

GROUND LEVEL

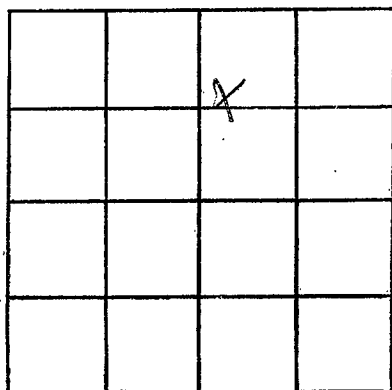

SECTION 22

Please indicate well location X.

ADDITIONAL INFORMATION

If more than one screen,
show locations of each on sketch.