

Pike
Cade

MISSISSIPPI
BOARD OF WATER COMMISSIONERS
416 North State Street
Jackson, Mississippi 39201

WATER WELL DRILLERS LOG

8-19 1982 Fitzgerald Well Drilling, Inc. Pike
date well completed firm name county well located

LANDOWNER:
Mac Parker
Rt 1 Express Dr.
(mailing address)

description of formations encountered	from	to
Red Clay	0	20
Red Sand	20	90
White Chalk	90	135
Coarse Sand & gravel	135	155

WELL LOCATION:
sec. 1 T 4 N R 9 E
S W
4 miles NW of ENOLA
(distance) (direction) (nearest town)

WELL PURPOSE: Home
(home, irrigation, municipal, industrial)

- WELL COMPLETION DATA:
- (1) diameter (inches) 4
 - (2) total depth (feet) 155
 - (3) static water level (feet) 90 below top of ground.
 - (4) casing PVC, 147 (material) (depth)
4 (size) If telescope see back.
 - (5) screen 8, 147 (length) (depth to top)
4 (size) PVC (material)
 - (6) pump 1/2 (HP) 10 (yield gpm)
alt. (type power)
 - (7) electric log no (yes or/no)
(organization running log)
 - (8) how well bottom plugged Salt Lake

DRILLERS REMARKS:


DEPT. OF NATURAL RESOURCES
BUREAU OF LAND & WATER RESOURCES


OCT 18 1982

RECEIVED

If well telescopes please sketch and show depths.

GROUND LEVEL

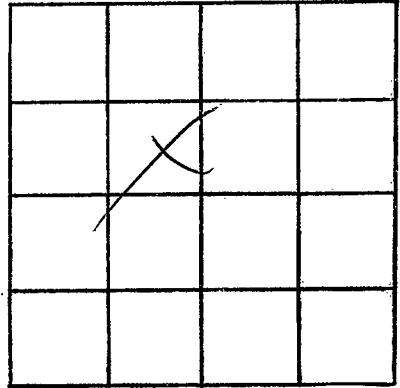

SECTION 

Please indicate well location X.

ADDITIONAL INFORMATION

If more than one screen,
show locations of each on sketch.