

PIKE
C
2008

MISSISSIPPI DEPARTMENT OF NATURAL RESOURCES
Bureau of Land and Water Resources
Southport Mall
P.O. Box 10631
Jackson, Mississippi 39209
WATER WELL DRILLERS LOG

2-23 1983 Fitzgerald Well Serv Pike
date well completed firm name county well located

LANDOWNER:
Powers
Rodius Donaway
P.O. 1 Jayess ms
(mailing address)

description of formations encountered	from	to
<u>Red Clay</u>	<u>0</u>	<u>20</u>
<u>Red sand</u>	<u>20</u>	<u>85</u>
<u>Coarse sand & gravel</u>	<u>85</u>	<u>160</u>

WELL LOCATION:
sec. 15 T 4 N R 9 E
S W
7 miles N of Fredale
(distance) (direction) (nearest town)

WELL PURPOSE:
(home, irrigation, municipal, industrial) Home

- WELL COMPLETION DATA:
- (1) diameter (inches) 4
- (2) total depth (feet) 160
- (3) static water level (feet) 55 below above top of ground.
- (4) casing pvc, 92,
(material) (depth)
4 If telescope see back.
(size)
- (5) screen 8, 92
(length) (depth to top)
4, pvc
(size) (material)
- (6) pump 1/2, 10
(HP) (yield gpm)
Elva
(type power)
- (7) electric log no
(yes or no)

(organization running log)
- (8) how well bottom plugged Sand Seal

DRILLERS REMARKS: _____


DEPT. OF NATURAL RESOURCES
BUREAU OF LAND & WATER RESOURCES

MAR - 2 1983

RECEIVED

If well telescopes please sketch and show depths.

GROUND LEVEL

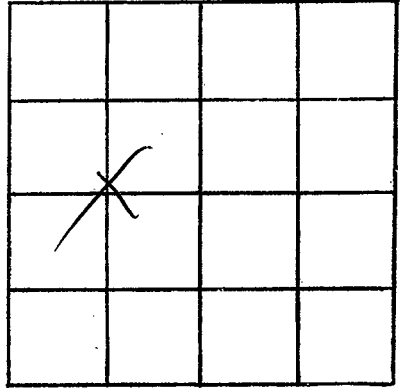

SECTION 15

Please indicate well location X.

ADDITIONAL INFORMATION

If more than one screen,
show locations of each on sketch.