

**PIKE**  
 C  
 2070

MISSISSIPPI DEPARTMENT OF NATURAL RESOURCES  
 Bureau of Land and Water Resources  
 Southport Mall  
 P.O. Box 10631  
 Jackson, Mississippi 39209  
**WATER WELL DRILLERS LOG**


4-12 1983 *Flomville Well Service* *Pike*  
 date well completed firm name county well located

LANDOWNER:	description of formations encountered	from	to
<i>Floria Taylor</i> <i>RR 10 Summit Ms.</i> (mailing address)			
WELL LOCATION:			
sec. <i>18</i> T. <i>4</i> N. R. <i>9</i> E S W			
<i>2</i> miles <i>W</i> of <i>Flomville</i> (distance) (direction) (nearest town)			
WELL PURPOSE: (home, irrigation, municipal, industrial)			
WELL COMPLETION DATA:			
(1) diameter (inches) <i>4</i>			
(2) total depth (feet) <i>133</i>			
(3) static water level (feet) <i>110</i> below top of ground.			
(4) casing <i>PVC</i> , <i>125</i> , (material) (depth) <i>4</i> (size) if telescope see back.			
(5) screen <i>8</i> , <i>125</i> (length) (depth to top) <i>4</i> , <i>PVC</i> (size) (material)			
(6) pump <i>1/2</i> , <i>50</i> (HP) (yield gpm) <i>Electric</i> (type power)			
(7) electric log <i>no</i> (yes or no) <i>Flomville Well Service</i> (organization running log)			
(8) how well bottom plugged <i>Full</i>			
DRILLERS REMARKS:			

MISSISSIPPI DEPARTMENT OF NATURAL RESOURCES  
 BUREAU OF LAND AND WATER RESOURCES  
 MAY 9 - 1983  
 RECEIVED

If well telescopes please sketch and show depths.

GROUND LEVEL

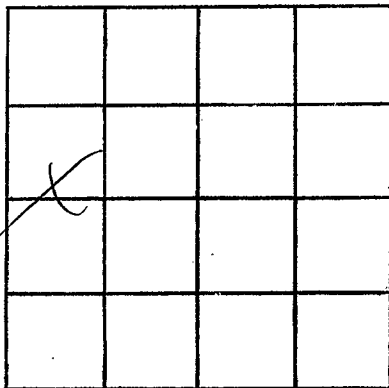

SECTION 18

Please indicate well location X.

ADDITIONAL INFORMATION

If more than one screen,  
show locations of each on sketch.