

MISSISSIPPI DEPARTMENT OF NATURAL RESOURCES

Bureau of Land and Water Resources

Southport Mall

P.O. Box 10631

Jackson, Mississippi 39209

WATER WELL DRILLERS LOG

Pike
C 2072

10-25 1983
 date well completed


F. J. Goodland & Son
 firm name

Pike
 county well located

LANDOWNER:	description of formations encountered	from	to
<i>Charles Sharp</i>	<i>Red clay</i>	<i>0</i>	<i>20</i>
<i>R.R. Jaynes, Inc.</i> (mailing address)	<i>Red sand</i>	<i>20</i>	<i>90</i>
WELL LOCATION:	<i>Red sand & gravel</i>	<i>90</i>	<i>135</i>
sec. <i>23</i> T. <i>4</i> N. R. <i>9</i> E S W <i>4</i> miles <i>ENE</i> of <i>Rosedale</i> (distance) (direction) (nearest town)	<i>Course sand & gravel</i>	<i>135</i>	<i>147</i>
WELL PURPOSE: (home, irrigation, municipal, industrial)			
WELL COMPLETION DATA:			
(1) diameter (inches) <i>4"</i>	DEPT. OF NATURAL RESOURCES BUREAU OF LAND & WATER RESOURCES DEC - 9 1983 RECEIVED		
(2) total depth (feet) <i>155</i>			
(3) static water level (feet) <i>70</i> below top of ground.			
(4) casing <i>PVC</i> , <i>147</i> , (material) (depth)			
<i>4</i> if telescope see back. (size)			
(5) screen <i>8</i> , <i>147</i> (length) (depth to top)			
<i>4</i> , <i>PVC</i> (size) (material)			
(6) pump <i>1/2</i> , <i>10</i> (HP) (yield gpm)			
<i>gas</i> (type power)			
(7) electric log <i>no</i> (yes or no)			
(organization running log)			
(8) how well bottom plugged <i>Sand pack</i>			
DRILLERS REMARKS:			

If well telescopes please sketch and show depths.

GROUND LEVEL

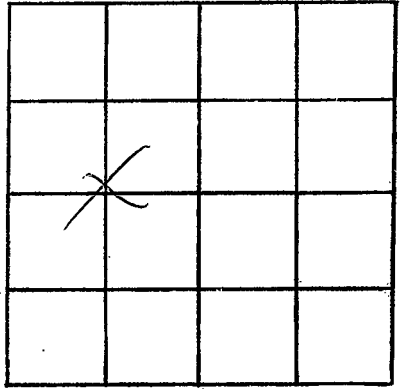

SECTION 23

Please indicate well location X.

ADDITIONAL INFORMATION

If more than one screen,
show locations of each on sketch.