

MISSISSIPPI DEPARTMENT OF NATURAL RESOURCES

Bureau of Land and Water Resources

Southport Mall

P.O. Box 10631

Jackson, Mississippi 39209

WATER WELL DRILLERS LOG

Pike  
C  
2073

1-26-84  
 date well completed

84 Hickwell  
 firm name

Pike  
 county well located

LANDOWNER:

William Moore

R.R. 1 Dyers  
 (mailing address)

description of formations encountered

from

to

red clay

0

20

red sand

20

70

white chert

70

120

coarse sand gravel

120

139

WELL LOCATION:

sec. 11 T 4 N R. 9 E  
 S W  
4 miles W of Pinola  
 (distance) (direction) (nearest town)

WELL PURPOSE:

Home  
 (home, irrigation, municipal, industrial)

WELL COMPLETION DATA:

- (1) diameter (inches) 4
- (2) total depth (feet) 139
- (3) static water level (feet) 90 below above top of ground.
- (4) casing PVC, 131,  
 (material) (depth)  
4 if telescope see back.  
 (size)
- (5) screen 8, 131  
 (length) (depth to top)  
4, PVC  
 (size) (material)
- (6) pump 1/2, 10  
 (HP) (yield gpm)  
Electric  
 (type power)
- (7) electric log no  
 (yes or no)  
Salter  
 (organization running log)
- (8) how well bottom plugged Salter

DRILLERS REMARKS:


DEPT. OF NATURAL RESOURCES  
 BUREAU OF LAND & WATER RESOURCES

MAR - 8 1984

RECEIVED

If well telescopes please sketch and show depths.

GROUND LEVEL

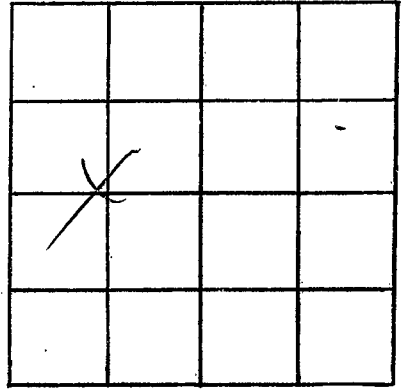

SECTION 11

Please indicate well location X.

ADDITIONAL INFORMATION

If more than one screen,  
show locations of each on sketch.