

MISSISSIPPI DEPARTMENT OF NATURAL RESOURCES

Bureau of Land and Water Resources

Southport Mall

P.O. Box 10631

Jackson, Mississippi 39209

WATER WELL DRILLERS LOG

Pike
C
2074

2-8
 date well completed

84 Howard Hill R
 firm name

Pike
 county well located


LANDOWNER:	description of formations encountered	from	to
<u>Dave Turner</u>	<u>Red Clay</u>	<u>0</u>	<u>20</u>
<u>R.R. Roth</u>	<u>Red Sand</u>	<u>20</u>	<u>90</u>
<u>(mailing address)</u>	<u>Coarse Sand & gravel</u>	<u>90</u>	<u>106</u>
WELL LOCATION:			
sec. <u>17</u> T <u>4</u> N R <u>9</u> E S W			
<u>2</u> miles <u>NE</u> of <u>Felders</u> (distance) (direction) (nearest town)			
WELL PURPOSE: (home, irrigation, municipal, industrial)			
<u>Home</u>			
WELL COMPLETION DATA:			
(1) diameter (inches) <u>4</u>			
(2) total depth (feet) <u>106</u>			
(3) static water level (feet) <u>80</u> below above top of ground.			
(4) casing <u>PVC</u> , <u>98</u> (material) (depth)			
<u>4</u> if telescope see back. (size)			
(5) screen <u>8</u> , <u>98</u> (length) (depth to top)			
<u>4</u> , <u>PVC</u> (size) (material)			
(6) pump <u>1/2</u> , <u>10</u> (HP) (yield gpm)			
<u>Electric</u> (type power)			
(7) electric log <u>no</u> (yes or no)			
<u>Paul Hill</u> (organization running log)			
(8) how well bottom plugged			
DRILLERS REMARKS:			

DEPT OF NATURAL RESOURCES
 BUREAU OF LAND & WATER RESOURCES

MAR - 8 1984
 RECEIVED

If well telescopes please
sketch and show depths.

GROUND LEVEL

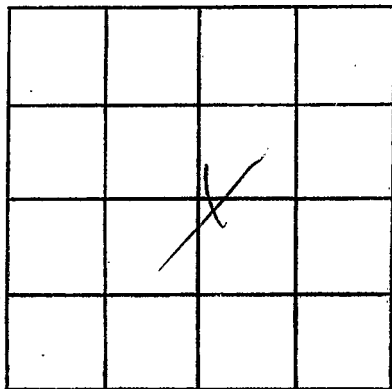

SECTION 17

Please indicate well location X.

ADDITIONAL INFORMATION

If more than one screen,
show locations of each on sketch.