

MISSISSIPPI DEPARTMENT OF NATURAL RESOURCES

Bureau of Land and Water Resources

Southport Mall

P.O. Box 10631

Jackson, Mississippi 39209

WATER WELL DRILLERS LOG

Pike
C
2075

2-15

1984

Fitzgerald

firm name

Pike

county well located

LANDOWNER:

Acubey McEwen

P.O. Summit, Mo.
(mailing address)

description of formations encountered

from

to

Red clay

0

20

Red sand

20

60

Coarse sandstone

60

80

WELL LOCATION:

sec. 28 T. 4 N R. 9 E
S W

1 miles W of Pinhook
(distance) (direction) (nearest town)

WELL PURPOSE:

(home, irrigation, municipal, industrial)

WELL COMPLETION DATA:

- (1) diameter (inches) 4
- (2) total depth (feet) 80
- (3) static water level (feet) 45 below top of ground.

(4) casing PVC, 72
(material) (depth)

4 if telescope see back.
(size)

(5) screen 8, 72
(length) (depth to top)

4, PVC
(size) (material)

(6) pump 1/2, 10
(HP) (yield gpm)

Elc
(type power)

(7) electric log No
(yes or no)

(organization running log)

(8) how well bottom plugged Sealed

DEPT. OF NATURAL RESOURCES
BUREAU OF LAND & WATER RESOURCES


MAR -7 1984

RECEIVED

DRILLERS REMARKS:

If well telescopes please sketch and show depths.

GROUND LEVEL

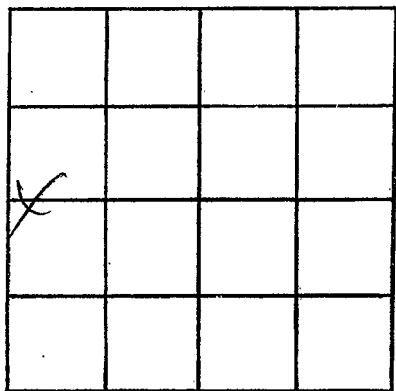

SECTION 28

Please indicate well location X.

ADDITIONAL INFORMATION

If more than one screen, show locations of each on sketch.