

MISSISSIPPI DEPARTMENT OF NATURAL RESOURCES

Bureau of Land and Water Resources

Southport Mall

P.O. Box 10631

Jackson, Mississippi 39209

WATER WELL DRILLERS LOG

PIKE
C 2077

8-2
date well completed

1984 Hugheswell Sew
firm name

Pike
county well located

LANDOWNER:

Joey Richard
B.R. Jones, ms.
(mailing address)

description of formations encountered

from

to

<u>Red clay</u>	<u>0</u>	<u>20</u>
<u>Red sand</u>	<u>20</u>	<u>70</u>
<u>Coarse sand & gravel</u>	<u>70</u>	<u>90</u>

WELL LOCATION:

sec. 21 T. 4 N R. 9 E
S W
1/2 miles NW of Pineblake
(distance) (direction) (nearest town)

WELL PURPOSE:

Flow
(home, irrigation, municipal, industrial)

WELL COMPLETION DATA:

- (1) diameter (inches) 4
- (2) total depth (feet) 90
- (3) static water level (feet) 45 below above top of ground.
- (4) casing PVC, 82,
(material) (depth)
4 if telescope see back.
(size)
- (5) screen 8, 82
(length) (depth to top)
4, PVC
(size) (material)
- (6) pump 1/2, 10
(HP) (yield gpm)
Elco
(type power)
- (7) electric log No
(yes or no)
(organization running log)
- (8) how well bottom plugged Sand fill

DEPT OF NATURAL RESOURCES
BUREAU OF LAND & WATER RESOURCES


AUG 23 1984

RECEIVED

DRILLERS REMARKS:

If well telescopes please
sketch and show depths.

GROUND LEVEL

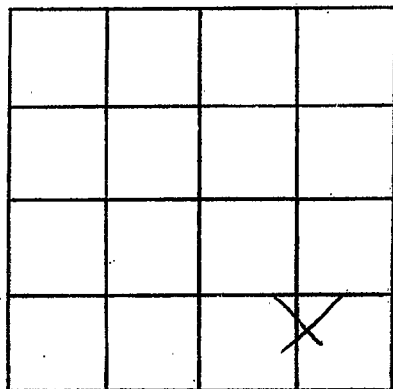

SECTION 21

Please indicate well location X.

ADDITIONAL INFORMATION

If more than one screen,
show locations of each on sketch.