

MISSISSIPPI DEPARTMENT OF NATURAL RESOURCES

Bureau of Land and Water Resources

Southport Mall

P.O. Box 10631

Jackson, Mississippi 39209

WATER WELL DRILLERS LOG

PIKE  
C 2009

10-26 1984  
date well completed

Fitzgerald well Co  
firm name

Pike  
county well located

LANDOWNER:  
Royal Smith  
P.R.T. Summit Co.  
(mailing address)

description of formations encountered	from	to
<u>Red clay</u>	<u>0</u>	<u>20</u>
<u>Red sand</u>	<u>20</u>	<u>90</u>
<u>white chalk</u>	<u>90</u>	<u>135</u>
<u>course sandstone</u>	<u>135</u>	<u>150</u>

WELL LOCATION:  
sec. 39 T. 4 N R. 9 E  
S W  
1 1/2 miles W of Pinckney  
(distance) (direction) (nearest town)

WELL PURPOSE: flow  
(home, irrigation, municipal, industrial)

- WELL COMPLETION DATA:
- (1) diameter (inches) 4
  - (2) total depth (feet) 150
  - (3) static water level (feet) 100 below above top of ground.
  - (4) casing 1 1/2" PVC (material) 142 (depth)  
4 (size) If telescope see back.
  - (5) screen 8 (length) 142 (depth to top)  
4 (size) PVC (material)
  - (6) pump 1/2 (HP) 10 (yield gpm)  
elec (type power)
  - (7) electric log no (yes or no)  
(organization running log)
  - (8) how well bottom plugged Seal the

DEPT. OF NATURAL RESOURCES  
BUREAU OF LAND & WATER RESOURCES


DEC -4 1984

RECEIVED

DRILLERS REMARKS:

If well telescopes please sketch and show depths.

GROUND LEVEL

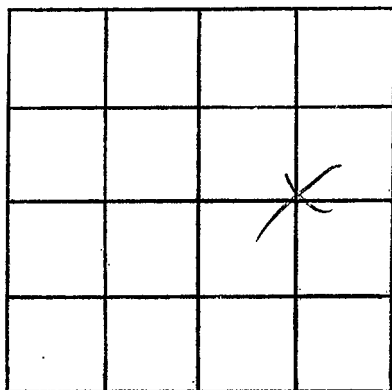

SECTION 29

Please indicate well location X.

ADDITIONAL INFORMATION

If more than one screen,  
show locations of each on sketch.