

MISSISSIPPI DEPARTMENT OF NATURAL RESOURCES

Bureau of Land and Water Resources

Southport Mall

P.O. Box 10631

Jackson, Mississippi 39209

WATER WELL DRILLERS LOG

Pike
C 2081
6-25-85

L

6-25-85 date well completed
F. Greenblatt, Inc. firm name
Pike county well located

LANDOWNER:
Jim Pierce
R.R. 1, Osprey, Miss.
(mailing address)

description of formations encountered	from	to
Red clay	0	20
Red sand	20	110
Coarse sand & gravel	110	126

WELL LOCATION:
sec. 3 T 4 N R 9 E
S W
4 miles N of Osprey
(distance) (direction) (nearest town)

WELL PURPOSE:
Home
(home, irrigation, municipal, industrial)

- WELL COMPLETION DATA:
- (1) diameter (inches) 4
 - (2) total depth (feet) 126
 - (3) static water level (feet) 90 below above top of ground.
 - (4) casing PVC, 116 (material), (depth)
4 (size) if telescope see back.
 - (5) screen 8, 116 (length), (depth to top)
4 (size), PVC (material)
 - (6) pump 1/2 (HP), 10 (yield gpm)
Ela (type power)
 - (7) electric log no (yes or no)
(organization running log)
 - (8) how well bottom plugged

RECEIVED


JUL 22 1985

DRILLERS REMARKS:

Department of Natural Resources
Bureau of Land & Water Resources

If well telescopes please sketch and show depths.

GROUND LEVEL

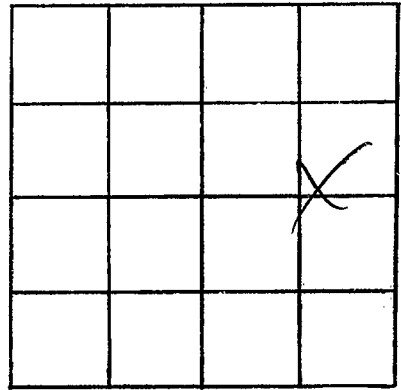

SECTION 3

Please indicate well location X.

ADDITIONAL INFORMATION

If more than one screen,
show locations of each on sketch.