

MISSISSIPPI DEPARTMENT OF NATURAL RESOURCES
Bureau of Land and Water Resources
 Southport Mall
 P.O. Box 10631
 Jackson, Mississippi 39209
WATER WELL DRILLERS LOG

Pike
C 2082
5-31-85

L

5-31 1985 Flycatcher Lee Pike
 date well completed firm name county well located

LANDOWNER:	description of formations encountered	from	to
<u>H. M. Howell</u>			
<u>R. B. Jarvis</u> (mailing address)	<u>Red Clay</u>	<u>0</u>	<u>20</u>
	<u>Red Sand</u>	<u>20</u>	<u>90</u>
	<u>Coarse Sand & gravel</u>	<u>90</u>	<u>112</u>
WELL LOCATION:			
sec. <u>15</u> T <u>4</u> N R <u>9</u> E S W			
<u>3</u> miles <u>N</u> of <u>Precedale</u> (distance) (direction) (nearest town)			
WELL PURPOSE: <u>Home</u> (home, irrigation, municipal, industrial)			
WELL COMPLETION DATA:			
(1) diameter (inches) <u>4</u>			
(2) total depth (feet) <u>112</u>			
(3) static water level (feet) <u>70</u> below top of ground.			
(4) casing <u>PVC</u> , <u>102</u> , (material) (depth), <u>4</u> (size) if telescope see back.			
(5) screen <u>10</u> , <u>102</u> (length) (depth to top) <u>4</u> , <u>PVC</u> (size) (material)			
(6) pump <u>1/2</u> , <u>10</u> (HP) (yield gpm) <u>Electric</u> (type power)			
(7) electric log <u>No</u> (yes or no) <u> </u> (organization running log)			
(8) how well bottom plugged <u>Small Shale</u>			


RECEIVED
 JUL 22 1985

DRILLERS REMARKS:

Department of Natural Resources
 Bureau of Land & Water Resources

If well telescopes please sketch and show depths.

GROUND LEVEL

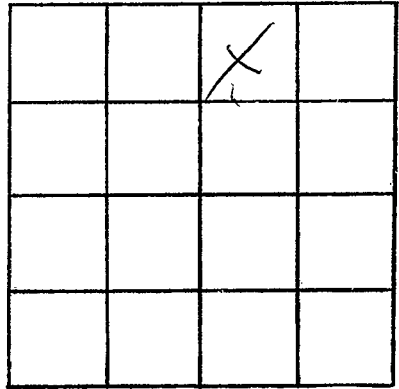

SECTION 15

Please indicate well location X.

ADDITIONAL INFORMATION

If more than one screen,
show locations of each on sketch.