

MISSISSIPPI DEPARTMENT OF NATURAL RESOURCES

Bureau of Land and Water Resources

Southport Mall

P.O. Box 10631

Jackson, Mississippi 39209

WATER WELL DRILLERS LOG

Pike
C 2083
7-11-85

7-11 1985 *F. J. Goodall Well Serv* *Pike*  
 date well completed firm name county well located

LANDOWNER:	description of formations encountered	from	to
<i>Mathew Lyons</i>			
<i>R.B. Jones, Mrs.</i> (mailing address)	<i>Red Clay</i>	<i>0</i>	<i>20</i>
	<i>White Chalk</i>	<i>20</i>	<i>102</i>
	<i>Coarse Sandstone</i>	<i>102</i>	<i>118</i>
WELL LOCATION:			
sec. <i>26</i> T <i>4</i> (N) R <i>9</i> (E) W			
<i>2</i> miles (distance) <i>E</i> (direction) of <i>Pinedale</i> (nearest town)			
WELL PURPOSE: <i>Home</i> (home, irrigation, municipal, industrial)			
WELL COMPLETION DATA:			
(1) diameter (inches) <i>4</i>			
(2) total depth (feet) <i>118</i>			
(3) static water level (feet) <i>45</i> below above top of ground.			
(4) casing <i>PVC</i> / <i>108</i> (material) (depth)			
<i>4</i> (size) if telescope see back.			
(5) screen <i>10</i> / <i>108</i> (length) (depth to top)			
<i>4</i> (size) <i>PVC</i> (material)			
(6) pump <i>1/2</i> / <i>10</i> (HP) (yield gpm)			
<i>Elec</i> (type power)			
(7) electric log <i>No</i> (yes or no)			
(organization running log)			
(8) how well bottom plugged <i>Sand Plug</i>			
DRILLERS REMARKS:			


RECEIVED

JUL 25 1985

Department of Natural Resources  
 Bureau of Land & Water Resources

If well telescopes please sketch and show depths.

GROUND LEVEL

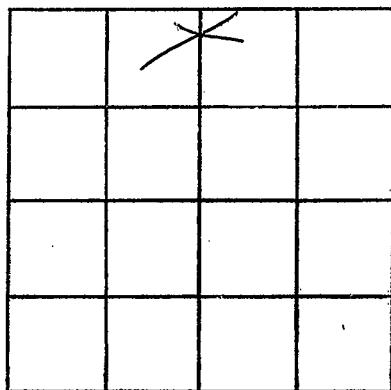

SECTION 26

Please indicate well location X.

ADDITIONAL INFORMATION

If more than one screen,  
show locations of each on sketch.