

PIKE
CA085

MISSISSIPPI DEPARTMENT OF NATURAL RESOURCES
Bureau of Land and Water Resources
Southport Mall
P.O. Box 10631
Jackson, Mississippi 39209
WATER WELL DRILLERS LOG

10-7 1985 Fitzgerald well Ser Pike
date well completed firm name county well located

LANDOWNER:
Dick Allen
RR-1 Summit ms.
(mailing address)

description of formations encountered	from	to
<u>Red clay</u>	<u>0</u>	<u>20</u>
<u>Red sand</u>	<u>20</u>	<u>145</u>
<u>Coarse sand & gravel</u>	<u>145</u>	<u>160</u>

WELL LOCATION:
sec. 29 T 4 N R 9 E
 S W
2 miles W of Prichard
(distance) (direction) (nearest town)

WELL PURPOSE: Home
(home, irrigation, municipal, industrial)

WELL COMPLETION DATA:

- (1) diameter (inches) 4
- (2) total depth (feet) 160
- (3) static water level (feet) 130 below above
top of ground.
- (4) casing pvc, 150,
(material) (depth)
4
(size) if telescope see back.
- (5) screen 10, 150
(length) (depth to top)
4, pvc
(size) (material)
- (6) pump 3/4, 15
(HP) (yield gpm)
elec
(type power)
- (7) electric log no
(yes or no)


(organization running log)
- (8) how well bottom plugged good

RECEIVED
NOV - 5 1985

DRILLERS REMARKS:

If well telescopes please sketch and show depths.

GROUND LEVEL

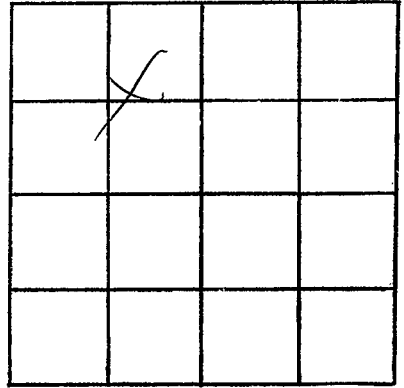

SECTION 29

Please indicate well location X.

ADDITIONAL INFORMATION

If more than one screen,
show locations of each on sketch.